

LEE

MISSISSIPPI BOARD OF WATER COMMISSIONERS

H56

9-29-60

WATER WELL DRILLERS LOG

Herndon Well & Supply Co.

SHANNON, MISS.

Date: Sept 29, 1960, Driller: \_\_\_\_\_ County Lee

(Name)

(1) Owner of Land: Grady McCorkel  
(Name)

Box 2 Tupelo, Miss  
(Address)

(2) Location: 1/4, 1/4, Sec 36 T 9 R 6

6 miles East of Tupelo  
(distance) (direction) (Nearest Town)

(3) Topography: Hilly  
(Hilly) (Flat) (Level)

(4) Purpose of Well: Home use  
(Domestic Irrigation Municipal, Industrial, Other)

Description & Color of Materials  
Sand, Clay, Red Clay, Shell, etc.

Thick-  
ness  
Feet

Depth  
Feet

Sand & Clay

100

Blue Rock

Sand

270

Bottom

378

Information upon completion of well:

(1) Diameter 4 inches.

(2) Total Depth 378 feet.

(3) Water Level 150 feet below top of ground.

(4) Cased to 104 1/2', Size 4"

(5) Screen: Size \_\_\_\_\_, Length \_\_\_\_\_



(6) Were any formations sealed against pollution?

X yes, \_\_\_\_\_ no.

If YES depth of formation 100 ft

Why Silt and Sand

Drillers Remarks: \_\_\_\_\_

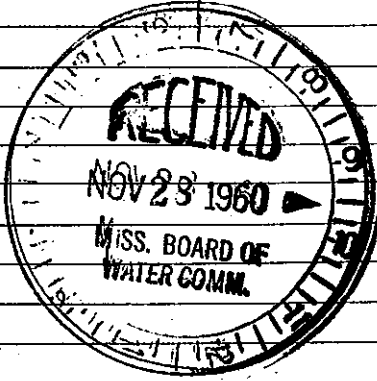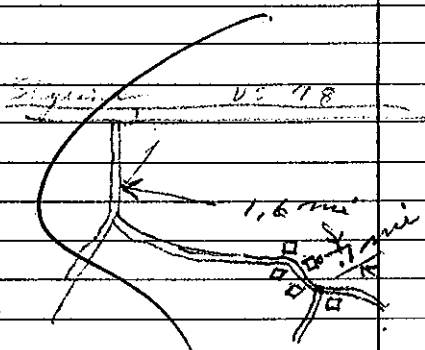

(Use Back Side)

Well No.

Mail this copy to Board of Water Commissioners 429 Miss. St. Jackson, Miss