

MISSISSIPPI BOARD OF WATER COMMISSIONERS

WATER WELL DRILLERS LOG

HERNDON WELL & SUPPLY CO.


LEE  
H 58  
3-15-63

Date March 15, 19 63, Driller: HERNDON WELL & SUPPLY CO. P. O. BOX 48 County Lee  
SHANNON, MISSISSIPPI

	Description & Color of Materials Sand, Clay, Red Clay, Shell, etc.	Thick- ness Feet	Depth Feet
(1) Owner of Land: <u>Jessie Hand</u> (Name) <u>At 7 Salkillo, Miss</u> (Address)	<u>surface sand</u> <u>&amp; clay</u>		<u>0</u>
(2) Location: <u>10</u> $\frac{1}{4}$ , <u>95</u> $\frac{1}{4}$ , Sec. <u>10</u> T. <u>10</u> R. <u>10</u> <u>1/2</u> miles <u>N.E.</u> of <u>Poplar</u> (distance) (direction) (Nearest Town)	<u>Blue sand</u> <u>&amp;</u> <u>sand</u>	<u>1</u> <u>50</u> <u>2</u> <u>80</u>	
(3) Topography: <u>Hilly</u> (Hilly) (Flat) (Level)	<u>Bottom</u>		<u>4</u> <u>00</u>
(4) Purpose of Well: <u>Domestic</u> (Domestic Irrigation Municipal, Industrial, Other)			

Information upon completion of well:

- (1) Diameter 4 inches.
- (2) Total Depth 400 feet.
- (3) Water Level 80 feet below top of ground.
- (4) Cased to 198' 8", Size 4"
- (5) Screen: Size \_\_\_\_\_, Length \_\_\_\_\_
- (6) Were any formations sealed against pollution?  
 yes, \_\_\_\_\_ no.
- If YES depth of formation 150'
- Why surface & sand
- Drillers Remarks: \_\_\_\_\_

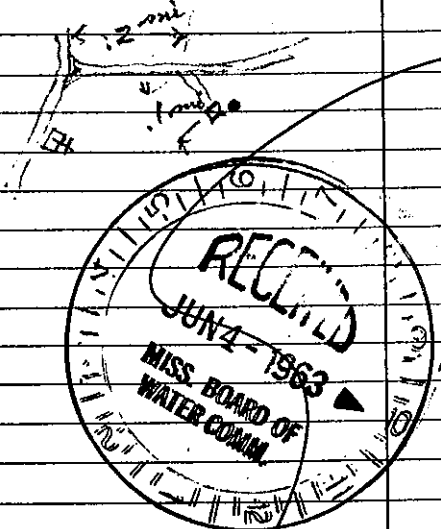

144 ELEV 380

(Use Back Side)

Well No.

Mail this copy to Board of Water Commissioners 429 Miss. St. Jackson, Miss.