

MISSISSIPPI BOARD OF WATER COMMISSIONERS

LEE
H 59
9-13-62

WATER WELL DRILLERS LOG

HERNDON WELL & SUPPLY CO.



Date: Feb 13, 1962, Driller: P. O. BOX 42 County Lee
SHANNON, MISSISSIPPI

(1) Owner of Land:	Description & Color of Materials	Thick-ness Feet	Depth Feet
(Name) <u>W. W. Sparks</u> (Address) <u>Rt 2 Sattillo, Miss.</u>	<u>Surface sand</u>		<u>0</u>
(2) Location: <u>1/4</u> , <u>1/4</u> , <u>16 956 E</u> Seg. <u>T. R. 6 E</u> <u>3</u> miles <u>N.E.</u> of <u>Tupelo</u> (distance) (direction) (Nearest Town)	<u>clay</u> <u>blue sand</u>		<u>60</u>
(3) Topography: <u>Hilly</u> (Hilly) (Flat) (Level)	<u>sand</u>		<u>240</u>
(4) Purpose of Well: <u>Domestic</u> (Domestic Irrigation Municipal, Industrial, Other)	<u>bottom</u>		<u>360</u>

Information upon completion of well:

- (1) Diameter 4 inches.
- (2) Total Depth 360 feet.
77.9 3/2/67
- (3) Water Level 60 feet below top of ground.
- (4) Cased to 64 ft, Size 4 in.
- (5) Screen: Size _____, Length _____.
- (6) Were any formations sealed against pollution?
 yes, _____ no.

If YES depth of formation 60 ft.
 Why surface sand
 Drillers Remarks: _____

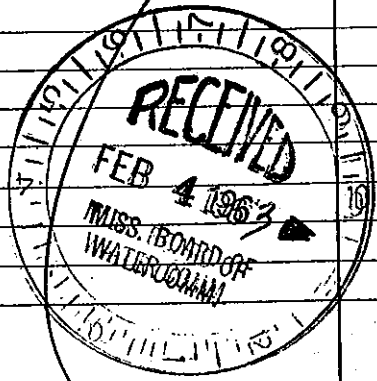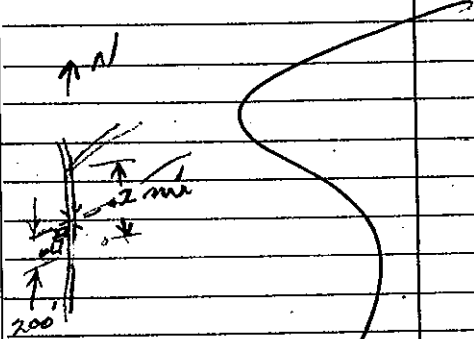

141 ELEV 282

Well No.

(Use Back Side)