

LEE
H 60
6-5-61

MISSISSIPPI BOARD OF WATER COMMISSIONERS

WATER WELL DRILLERS LOG
HERNDON WELL & SUPPLY CO.

H-307
H310

Date: June 5, 1961, Driller: SHANNON P.O. BOX 42 County Lee
(Name) MISSISSIPPI

(1) Owner of Land: <u>Oak Hill Church</u> <small>(Name)</small>	Description & Color of Materials Sand, Clay, Red Clay, Shell, etc.	Thick- ness Feet	Depth Feet
<u>At 2 Sathilla, Miss</u> <small>(Address)</small>	<u>gumbo sand & clay</u>		0
(2) Location: <u>1/4, 1/4, Sec 10 T. 9 S. R. 6 E</u> <u>5 miles NE of Tupelo</u> <small>(distance) (direction) (Nearest Town)</small>	<u>Blue water sand</u>		95 320
(3) Topography: <u>Hills</u> <small>(Hilly) (Flat) (Level)</small>	<u>Pattern</u>		440
(4) Purpose of Well: <u>Church</u> <small>(Domestic Irrigation Municipal, Industrial, Other)</small>			

Information upon completion of well:



- (1) Diameter 4 inches.
- (2) Total Depth 440 feet.
- (3) Water Level 140' feet below top of ground.
- (4) Cased to 100', Size 4"
- (5) Screen: Size —, Length —
- (6) Were any formations sealed against pollution?
 yes, no.

If YES depth of formation 95'

Why Gumbo & sand

Drillers Remarks:

128' ELEV 410

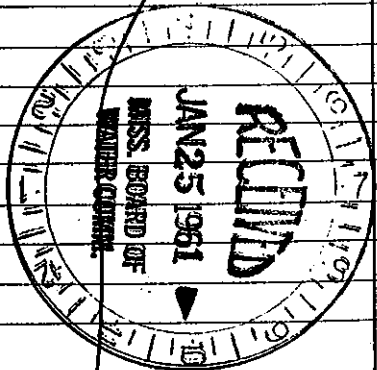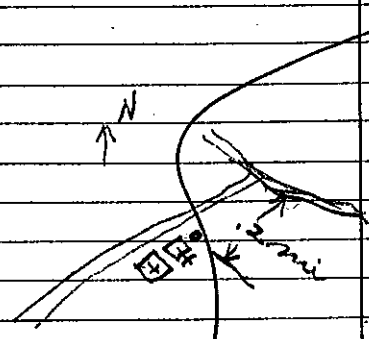

(Use Back Side)

Well No.