

Lee
H62
1-66

MISSISSIPPI BOARD OF WATER COMMISSIONERS

WATER WELL DRILLERS LOG

Herndon-Homan Well & Supply, Inc.

Date: Jan 7, 1966, Driller: SHANNON, MISSISSIPPI 38868
(When well drilled) (Name) (Where well is located)

(1) Owner of Land: <u>Hawley Goff</u> (Name)	Description & Color of Materials Sand, Clay, Red Clay, Shell, etc.	Thick- ness Feet	Depth Feet
<u>Shylin, Tupelo, MISS</u> (Address)	<u>surface sand & clay</u>	0	18
(2) Location <u>SE 1/4, NW 1/4, Sec. 35 T7 R6</u>	<u>Blue clay</u>	18	135
<u>1/2 miles E of Tupelo</u> (distance) (direction) (Nearest Town)	<u>Sand</u>	135	260
(3) Topography: <u>flat</u> (Hilly) (Flat) (Level)	<u>Bottom</u>	260	
(4) Purpose of Well: <u>Home</u> (Domestic Irrigation Municipal, Industrial, Other)	<u>Refrigeration on north side of HW 78</u>		

Information upon completion of well:

- (1) Diameter 5 inches.
- (2) Total Depth 260 feet.
90.3 3/1/67
- (3) Water Level 90 feet below top of ground.
- (4) Cased to 20', Size 5"
- (5) Screen: Size None, length _____
- (6) Were any formations sealed against pollution?
 yes, no.

If YES depth of formation 18'


Why Surface Sand

Drillers Remarks: _____

Yield in gpm: 5

Size pump: 1/3 sub.

Type power: Electric

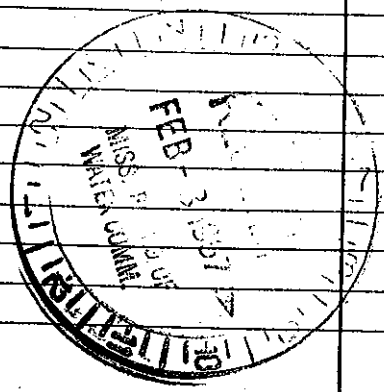

Mail this copy to Board of Water Commissioners 429 Miss. St. Jackson, Miss.
374 ELEU 296