

Lee
H 63
4-66

MISSISSIPPI BOARD OF WATER COMMISSIONERS

WATER WELL DRILLERS LOG

Date: April 11, 1966, Driller: Herndon-Homan Well & Supply, Inc. County Lee
(When well drilled) P. O. Box 48
SHANNON, MISSISSIPPI 38888 (Where well is located)

(1) Owner of Land:	Description & Color of Materials	Thick-ness Feet	Depth Feet
Howers Tackett (Name)	Surface sand & clay	16	16
Skeline Tupelo, Miss. (Address)	Blue clay	24	140
(2) Location: SE 1/4, Sec. 26, T. 5 N, R. 5 E	Sand	120	260
1/2 miles E of Tupelo (distance) (direction) (Nearest Town)	Water	260	
(3) Topography: Flat (Hilly) (Flat) (Level)			
(4) Purpose of Well: Beauty Shop (Domestic Irrigation Municipal, Industrial, Other)			

Information upon completion of well:

- (1) Diameter 5 inches.
- (2) Total Depth 260 feet.
- (3) Water Level 80 feet below top of ground.
- (4) Cased to 19', Size 5"
- (5) Screen: Size NONE, Length _____
- (6) Were any formations sealed against pollution?
yes, no.

If YES depth of formation 16'


Why Surface & sand

Drillers Remarks:

Yield in gpm: 5

Size pump: 1/2 HP

Type power: electric

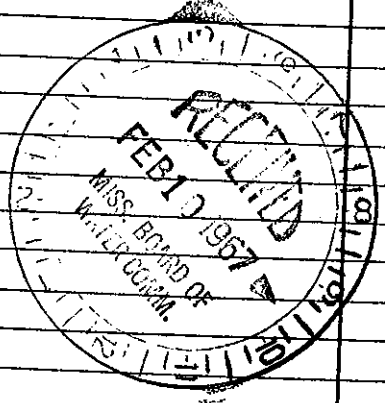

Mail this copy to Board of Water Commissioners 429 Miss. St. Jackson, Miss. 376 ELEU 295