

MISSISSIPPI BOARD OF WATER COMMISSIONERS

WATER WELL DRILLERS LOG

Date July 1, 1965, Driller: O. C. Webb Jr. County Lee
 (Name)

(1) Owner of Land:	Description & Color of Materials Sand, Clay, Red Clay, Shell, etc.	Thick- ness Feet	Depth Feet
<u>Mid. South Packers</u> (Name) <u>Supelo Miss</u> (Address)	<u>Soil 0 to 40 ft</u>		
(2) Location: <u>1/4</u> , <u>1/4</u> , Sec. <u>T</u> <u>R</u>	<u>Blue sand & soap stone</u>		
<u>0</u> miles (distance), of <u>Supelo</u> (Nearest Town)	<u>45 ft Shell Rock 2"</u>		
(3) Topography: <input checked="" type="checkbox"/> (Hilly) <input type="checkbox"/> (Flat) <input type="checkbox"/> (Level)	<u>Blue Rock to 194 ft</u>		
(4) Purpose of Well: (Domestic Irrigation, Municipal, Industrial, Other)	<u>4" Sand Rock water</u>		
	<u>Sand to 480 ft grained</u>		
	<u>together gravel 41 ft</u>		
	<u>0 1/2 pinched fine sand</u>		

Information upon completion of well:

(1) Diameter 12 inches. over 8"

(2) Total Depth 521 feet.

(3) Water Level 167 feet below top of ground.

(4) Cased to 191 ft 12", Size 12"

(5) Screen: Size 8, Length 80 ft


(6) Were any formations sealed against pollution?
yes, no.

If YES depth of formation _____

Why _____

Drillers Remarks: _____

149

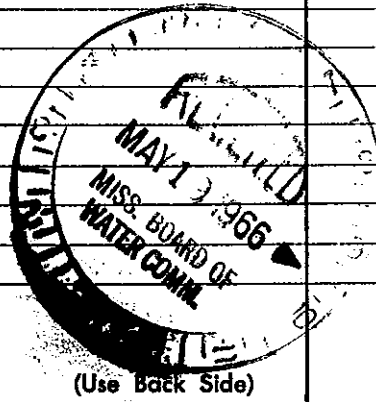

Well No.

Mail this copy to Board of Water Commissioners 429 Miss. St. Jackson, Miss.