

LEE
H 175
5-19-61

MISSISSIPPI BOARD OF WATER COMMISSIONERS

WATER WELL DRILLERS LOG

Date: May 19, 1961, Driller: O. C. Webb County Lee
Driller's Name (Name)

(1) Owner of Land:	Description & Color of Materials <small>Sand, Clay, Red Clay, Shell, etc.</small>	Thick- ness Feet	Depth Feet
(Name) <u>Tupelo Prosser</u>	<u>flat</u>		
(Address) <u>Tupelo Miss</u>	<u>sand & clay</u>		
(2) Location: <u>1/4</u> , <u>1/4</u> , Sec. <u>29</u> T <u>2</u> R <u>6</u> E	<u>to 80 ft. Blue</u>		
(distance) <u>1/2</u> miles <u>north</u> , of <u>Tupelo</u> , (direction) (Nearest Town)	<u>Marl to 300 ft</u> <u>sand Rock 4 in</u> <u>water sand</u> <u>to 540 ft</u>		
(3) Topography: <input checked="" type="checkbox"/> (Hilly) <input type="checkbox"/> (Flat) <input type="checkbox"/> (Level)			
(4) Purpose of Well: <small>(Domestic Irrigation, Municipal, Industrial, Other)</small>			


Information upon completion of well:

- (1) Diameter 6 inches.
- (2) Total Depth 540 feet.
165.0 4/19/67 ELEV 110
- (3) Water Level 120 feet below top of ground.
- (4) Cased to 93, Size 6
- (5) Screen: Size _____, Length _____
- (6) Were any formations sealed against pollution?
_____ yes, _____ no.

If YES depth of formation _____

Why _____

Drillers Remarks: sub pumps

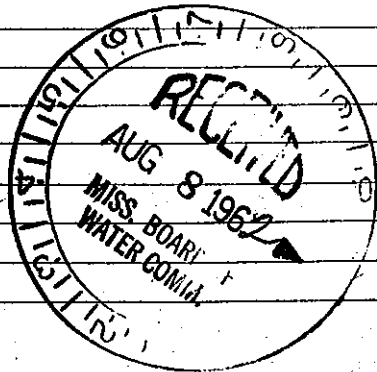

126 ELEV 280

(Use Back Side)

Well No.