

Lee  
H 81  
7-65

MISSISSIPPI BOARD OF WATER COMMISSIONERS

CODED

WATER WELL DRILLERS LOG

Herndon-Homan Well & Supply, Inc.

Date: July 29 1965, Driller: SHANNON, P. O. Box 42, Lee County, Mississippi  
(When well drilled) (Name) (Where well is located)

(1) Owner of Land: BOY BARNETT  
(Name)  
My Tupelo, Miss  
(Address)  
(2) Location: SE 1/4 NW 1/4, Sec 26 T7 R6  
2 1/2 miles North E of Tupelo  
(distance) (direction) (Nearest Town)  
(3) Topography: flat  
(Hilly) (flat) (Level)  
(4) Purpose of Well: Home  
(Domestic Irrigation, Municipal, Industrial, Other)


Description & Color of Materials Sand, Clay, Red Clay, Shell, etc.	Thick- ness Feet	Depth Feet
<u>surface mud &amp; clay</u>	<u>18</u>	<u>18</u>
<u>blue clay</u>	<u>182</u>	<u>200</u>
<u>Sand</u>	<u>120</u>	<u>320</u>
<u>Bottom</u>		<u>320</u>

*Similar to that shown on hill east of creek*

Information upon completion of well:

(1) Diameter 4 inches.  
(2) Total Depth 320 feet.  
(3) Water Level 75 feet below top of ground.  
(4) Cased to 21' 7", Size 4"  
(5) Screen: Size None Length \_\_\_\_\_  
(6) Were any formations sealed against pollution?  
 yes, \_\_\_\_\_ no.  
If YES depth of formation 18'  
Why surface & sand  
Drillers Remarks: \_\_\_\_\_  
Yield in gpm: 5  
Size pump: 3/4  
Type power: electric

CODED

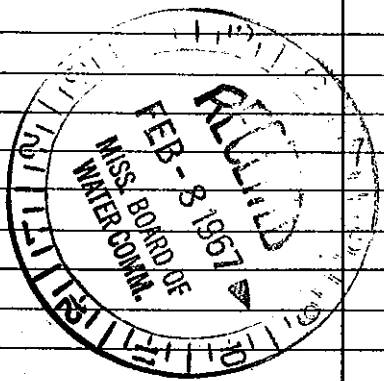

Mail this copy to Board of Water Commissioners 429 Miss. St. Jackson, Miss.