

Lee
H 82
2-66

CODED

MISSISSIPPI BOARD OF WATER COMMISSIONERS

WATER WELL DRILLERS LOG


Date: Feb. 17, 1966, Driller: Herndon-Homan Well & Supply, Inc.
(When well drilled) P. O. Box 42 County Lea
SHANNON, MISSISSIPPI 38868 Where well is located

(1) Owner of Land: <u>Red Low Pump</u> <small>(Name)</small>	Description & Color of Materials Sand, Clay, Red Clay, Shell, etc.	Thick- ness Feet	Depth Feet
<u>At 1 Galtville, Miss</u> <small>(Address)</small>	<u>surface sand & clay</u>	<u>140</u>	<u>140</u>
<u>SW 1/4, NE 1/4, Sec. 18 T9 N6</u>	<u>Blue clay</u>	<u>80</u>	<u>220</u>
<u>1 miles N</u> of <u>Topoka</u> <small>(distance) (direction) (Nearest town)</small>	<u>Sand</u>	<u>120</u>	<u>440</u>
(3) Topography: <u>Flat</u> <small>(Hilly) (Flat) (Level)</small>	<u>Behind and north of Dairy</u>		
(4) Purpose of Well: <u>Domestic</u> <small>(Domestic Irrigation) (Municipal, Industrial, Other)</small>			

Information upon completion of well:

- (1) Diameter 4 inches.
- (2) Total Depth 440 feet.
- (3) Water Level 50 feet below top of ground.
- (4) Cased to 260' 6" Size 4"
- (5) Screen: Size 2", Length 40'
- (6) Were any formations sealed against pollution?
 yes, no.

If YES depth of formation 140'
 Why Surface & Sand
 Drillers Remarks:
 Yield in gpm: 10
 Size pump: 1 1/2 Jet
 Type power: Electric

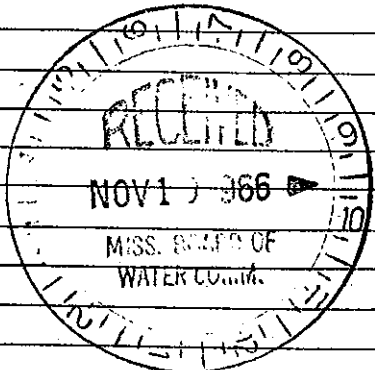

CODED

Mail this copy to Board of Water Commissioners 429 Miss. St. Jackson, Miss.
375