

Lee
H83
4-66

CODED

MISSISSIPPI BOARD OF WATER COMMISSIONERS

WATER WELL DRILLERS LOG

Herndon-Homan Well & Supply, Inc.

Date: April 16 1966, Driller: P. O. Box 42 County Lee
(When well drilled) SHANNON, MISSISSIPPI 38888 (Where well is located)


(1) Owner of Land:	Description & Color of Materials Sand, Clay, Red Clay, Shell, etc.	Thick- ness Feet	Depth Feet
<u>Wesley Howards</u> (Name)	<u>surface sand & clay</u>	<u>80</u>	<u>80</u>
<u>Box 2 Saffilo, Miss.</u> (Address)	<u>blue clay</u>	<u>160</u>	<u>240</u>
(2) Location: <u>SW 1/4 NE 1/4, Sec. 4 T9 R12</u>	<u>sand</u>	<u>120</u>	<u>360</u>
<u>3</u> miles <u>S</u> of <u>Saffilo</u> (distance) (direction) (Nearest Town)	<u>bottom</u>	<u>360</u>	
(3) Topography: <u>hilly</u> (Hilly) (Flat) (Level)			
(4) Purpose of Well: <u>Home</u> (Domestic Irrigation Municipal, Industrial, Other)			

Information upon completion of well:

- (1) Diameter 4 inches.
- (2) Total Depth 360 feet.
- (3) Water Level 83' feet below top of ground.
- (4) Cased to 84', Size 4"
- (5) Screen: Size NONE Length _____
- (6) Were any formations sealed against pollution?
 yes, no.

If YES depth of formation 80'
Why surface & sand
Drillers Remarks: _____
Yield in gpm: 3
Size pump: 1 1/2 HP
Type power: electric

CODED

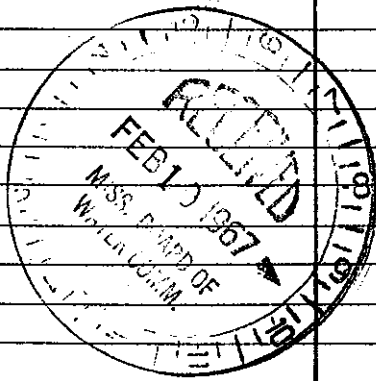

Mail this copy to Board of Water Commissioners 429 Miss. St. Jackson, Miss.

377