

Lee
H 84
8-66

CODED

MISSISSIPPI BOARD OF WATER COMMISSIONERS

WATER WELL DRILLERS LOG

Herndon-Homan Well & Supply, Inc.

Date: Aug 17, 19 66, Driller: SHANNON, P. O. Box 42 County Lee
(When well drilled) (Name) (Where well is located)

(1) Owner of Land:	Description & Color of Materials Sand, Clay, Red Clay, Shell, etc.	Thick- ness Feet	Depth Feet
<u>Ray Wicker</u> (Name) <u>Box 4 Tupelo, Miss.</u> (Address)	<u>surface sand & clay</u>	<u>34</u>	<u>34</u>
(2) Location: <u>SW 1/4, NE 1/4, Sec 25, T. 9 S, R. 16 E</u>	<u>Blue clay</u>	<u>166</u>	<u>200</u>
<u>3</u> miles <u>E</u> of <u>Tupelo</u> (distance) (direction) (Nearest Town)	<u>ground</u>	<u>1</u>	<u>320</u>
(3) Topography: <u>Hills</u> (Hilly) (Flat) (Level)	CODED		
(4) Purpose of Well: <u>Domestic</u> (Domestic Irrigation Municipal, Industrial, Other)			

Information upon completion of well:

- (1) Diameter 5 inches.
- (2) Total Depth 320 feet.
- (3) Water Level 135 feet below top of ground.
- (4) Cased to 36' 7", Size 5"
- (5) Screen: Size none, Length _____
- (6) Were any formations sealed against pollution?
yes, _____ no.

If YES depth of formation 34'


Why surface & sand

Drillers Remarks: _____

Yield in gpm: 5

Size pump: 1/2 HP Sub

Type power: Electric

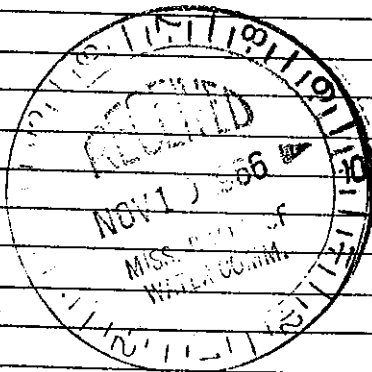

Mail this copy to Board of Water Commissioners 429 Miss. St. Jackson, Miss.

378