

CODED

LEE  
H 85  
Recd OFFICE 4-68

MISSISSIPPI  
BOARD OF WATER COMMISSIONERS  
416 North State Street  
Jackson, Mississippi 39201

WATER WELL DRILLERS LOG

J. W. Webb & Sons See

19 date well completed firm name county well located

LANDOWNER: J. W. WEBB  
Belden miss  
(mailing address)

description of formations encountered	from	to
Soil	0	30
sand & blue mail	30	160
Blue Rock	160	261
Water Sand Rock	261	263
Water Sand	263	400


WELL LOCATION:  
sec 9 T 9 N R 6 E  
S W  
6 miles north of Tupelo  
(distance) (direction) (nearest town)

WELL PURPOSE: municipal  
(home, irrigation, municipal, industrial)

WELL COMPLETION DATA:

- (1) diameter (inches) 6
- (2) total depth (feet) 400
- (3) static water level (feet) 187 below top of ground.
- (4) casing Steel 168 (material) (depth)
- (size) If telescope see back.
- (5) screen 60 (length) (depth to top)
- 4" (size) (material)
- (6) pump 2 HP 40 (HP) (yield gpm)
- (type power)
- (7) electric log No (yes or no)
- (organization running log)
- (8) how well bottom plugged Back Wall Plug

CODED

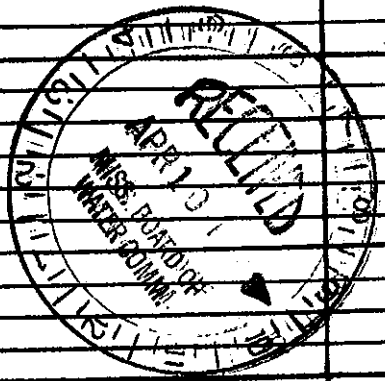

DRILLERS REMARKS: