

LEE  
H86  
8-9-60  
CODED

MISSISSIPPI BOARD OF WATER COMMISSIONERS


WATER WELL DRILLERS LOG

H301

Date: 8-9, 1960, Driller: O. C. Webb Jr County Lee  
(Name)

(1) Owner of Land:	Description & Color of Materials Sand, Clay, Red Clay, Shell, etc.	Thick- ness Feet	Depth Feet
<u>Paul Mitchel</u> (Name)	<u>soil to 20ft</u>		
<u>Supelo Miss.</u> (Address)	<u>sand to 80ft</u>		
(2) Location: <u>1/4, SE 1/4, Sec. 13 T9 R5</u> <u>SE</u>	<u>Rock 2 ft sand</u>		
<u>3</u> miles <u>North</u> , of <u>Supelo</u> (distance) (direction) (Nearest Town)	<u>+ Blue marl</u>		
(3) Topography: <input checked="" type="checkbox"/> (Hilly) <input type="checkbox"/> (Flat) <input type="checkbox"/> (Level)	<u>to 190ft blue</u>		
(4) Purpose of Well: <input checked="" type="checkbox"/> (Domestic Irrigation) <input type="checkbox"/> (Municipal, Industrial, Other)	<u>Rock to 345ft</u>		
Information upon completion of well:	<u>Water Rock 8pi</u>		
(1) Diameter <u>4</u> inches.	<u>Water sand</u>		
(2) Total Depth <u>490</u> feet.	<u>to 490ft</u>		
(3) Water Level <u>13.5</u> feet below top of ground.			
(4) Cased to <u>197</u> , Size <u>4"</u>			
(5) Screen: Size _____, Length _____			
(6) Were any formations sealed against pollution? _____ yes, _____ no.			
If YES depth of formation _____			
Why _____			
Drillers Remarks: _____			
_____			
_____			
CODED

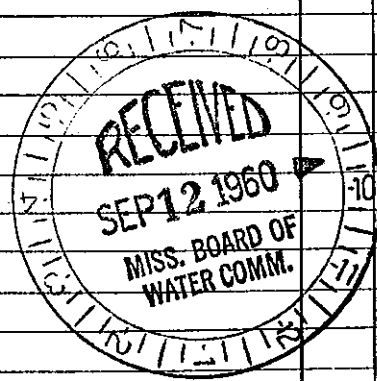

120

(Use Back Side)

Well No.

Mail this copy to Board of Water Commissioners 429 Miss. St. Jackson, Miss