

LEE CODED MISSISSIPPI BOARD OF WATER COMMISSIONERS

H 88  
11-23-60

WATER WELL DRILLERS LOG

H. 304

Herndon Well & Supply Co.

Date: 11/23, 1960, Driller: SHANNON, MISS. County Lee

(Name)

	Description & Color of Materials Sand, Clay, Red Clay, Shell, etc.	Thick- ness Feet	Depth Feet
(1) Owner of Land: <u>O.L. Dobbs</u> (Name) <u>Rt 2 South</u> (Address)	sand & clay Blue Rocks	55	
(2) Location: $\frac{1}{4}$ , $\frac{1}{4}$ , Sec. <u>16</u> T. <u>9S</u> R. <u>6E</u> <u>4</u> miles <u>NE</u> of <u>Leopold</u> (distance) (direction) (Nearest Town)	Sand to Bottom	260	370
(3) Topography: <u>Hilly</u> (Hilly) (Flat) (Level)			
(4) Purpose of Well: <u>Home use</u> (Domestic Irrigation Municipal, Industrial, Other)			

Information upon completion of well:


- (1) Diameter 4 inches.
- (2) Total Depth 370 feet.
- (3) Water Level 82' feet below top of ground.
- (4) Cased to 61' 5", Size 4"
- (5) Screen: Size     , Length
- (6) Were any formations sealed against pollution?  
 yes,  no.

If YES depth of formation \_\_\_\_\_

Why Surface & Sand

Drillers Remarks:

Top 10 ft. casing  
grouted according to  
12.5  
FHA specifications

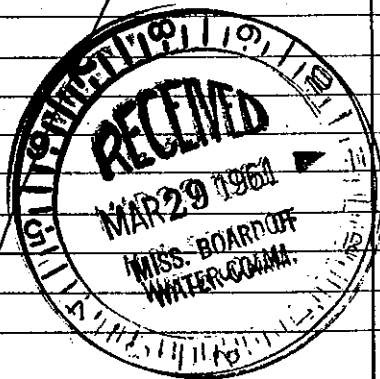

(Use Back Side)

Well No.