

LEE
H 89
4-25-62 CODED
Date: 4/25, 1962

WATER WELL DRILLERS LOG


Driller: Fowler County LEE
(Name)

(1) Owner of Land:	Description & Color of Materials	Thick-ness Feet	Depth Feet
<u>Luke McKinney</u> (Name)	<u>Shallow from</u> <u>branch on N. side</u> <u>of US 78</u> <u>brick house</u>		
<u>Fuplo</u> (Address)			
(2) Location: <u>1/4</u> , <u>1/4</u> , Sec. <u>29 T25R7E</u> <u>2 miles E</u> , of <u>Fuplo</u> (distance) (direction) (Nearest Town)			
(3) Topography: <u>flat</u> (Hilly) (Flat) (Level)			
(4) Purpose of Well: <u>Domestic</u> (Domestic Irrigation Municipal, Industrial, Other)			

Information upon completion of well:

- (1) Diameter 4 inches.
- (2) Total Depth 305' feet.
- (3) Water Level 70' feet below top of ground.
- (4) Cased to 21', Size _____, Size _____.
- (5) Screen: Size _____, Length _____.
- (6) Were any formations sealed against pollution?
 yes, no.

If YES depth of formation _____
Why _____
Drillers Remarks: _____

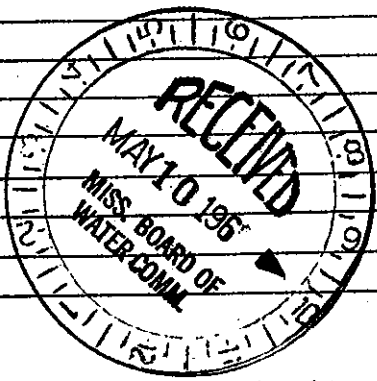

135

Well No.