

LEE
H 90 CODED
5-4-62

MISSISSIPPI BOARD OF WATER COMMISSIONERS

WATER WELL DRILLERS LOG

Date: May 4, 1962, Driller: HERNDON WELL & SUPPLY CO.
P.O. BOX 42 County Lee
Name SMANNON, MISSISSIPPI


(1) Owner of Land:	Description & Color of Materials Sand, Clay, Red Clay, Shell, etc.	Thick- ness Feet	Depth Feet
<u>Dudley T. McCulley</u> (Name) <u>At 2 Sattles, Miss</u> (Address)	<u>Surface sand</u> <u>& clay</u>		<u>0</u>
(2) Location: <u>1/4</u> , <u>1/4</u> , Sec <u>11</u> <u>95 E</u> <u>5 1/2</u> miles <u>NE</u> of <u>Temple</u> (distance) (direction) (Nearest Town)	<u>Blue rock</u> <u>to</u> <u>sand</u>	<u>225</u> <u>to</u> <u>320</u>	
(3) Topography: <u>Hills</u> (Hilly) (Flat) (Level)	<u>of</u>		
(4) Purpose of Well: <u>Domestic</u> (Domestic Irrigation Municipal, Industrial, Other)	<u>Bottom</u>		<u>440</u>

Information upon completion of well:

- (1) Diameter 4 inches.
- (2) Total Depth 440 feet.
- (3) Water Level _____ feet below top of ground.
- (4) Cased to 23 1/6" Size 4"
- (5) Screen: Size 2", Length 20' 0 1/2
- (6) Were any formations sealed against pollution?
 yes, _____ no.

If YES depth of formation 225
Why Surface sand
Drillers Remarks: Screened

big red brick on
east
green shingles house
and trailer in
yard

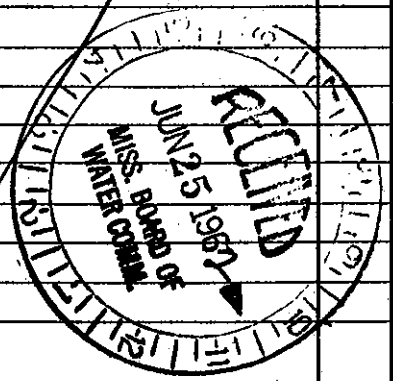

137

(Use Back Side)

Well No.