

LEE  
H 92  
7-9-62  
CODED

MISSISSIPPI BOARD OF WATER COMMISSIONERS  
WATER DRILLERS LOG

Date: July 9, 1962, Driller: HERNDON WELL & SUPPLY CO. County: Lee  
P.O. BOX 42  
MELANCON, MISSISSIPPI


(1) Owner of Land:	Description & Color of Materials	Thick-ness Feet	Depth Feet
<u>C. L. Shelley</u> (Name) <u>Rt 2 Tupelo, Miss.</u> (Address)	<u>Surface sand &amp; clay</u>		<u>0</u>
(2) Location: $\frac{1}{4}$ , $\frac{1}{4}$ , Sec. <u>34 95</u> T. <u>R. 6 E</u>	<u>Blue rock</u>	<u>18 ft</u>	
_____ miles _____ of <u>Shyline</u> (distance) (direction) (Nearest Town)	<u>Sand</u>	<u>180</u>	
(3) Topography: <u>Flat</u> (Hilly) (Flat) (Level)	<u>Bottom</u>	<u>300</u>	
(4) Purpose of Well: <u>Domestic</u> (Domestic irrigation Municipal, Industrial, Other)			

Information upon completion of well:

- (1) Diameter 4 inches.
- (2) Total Depth 300 feet.
- (3) Water Level 80 feet below top of ground.
- (4) Cased to 21' 6", Size 4"
- (5) Screen: Size \_\_\_\_\_, Length \_\_\_\_\_
- (6) Were any formations sealed against pollution?  
 yes, \_\_\_\_\_ no.

If YES depth of formation 18 ft.  
Why Surface & Sand  
Drillers Remarks: \_\_\_\_\_

139

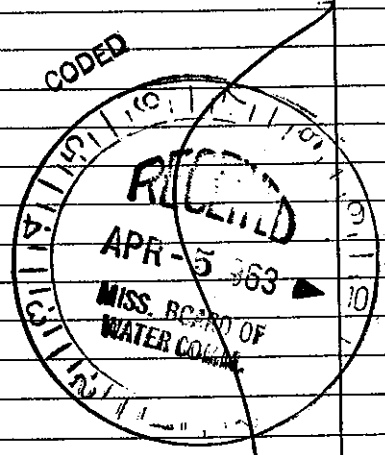

(Use Back Side)

Well No.