

LEE
H 94
5-8-64

MISSISSIPPI BOARD OF WATER COMMISSIONERS

CODED

WATER WELL DRILLERS LOG

Date: 5-8, 1964, Driller: O.C. Webb Jr County Lee
(Name)

(1) Owner of Land: Fletcher Stanford
(Name)
Yupelo Miss
(Address)

(2) Location: 1/4, 1/4, Sec. 7 SE 9 R6
(distance) (direction) (Nearest Town)

(3) Topography: (Hilly) (Flat) (Level)

(4) Purpose of Well: (Domestic Irrigation) (Municipal, Industrial, Other)

Description & Color of Materials Sand, Clay, Red Clay, Shell, etc.	Thick- ness Feet	Depth Feet
Soil to 30ft blue		
sand to 100ft		
18 in sand Rock		
blue sand to 130		
ft Blue marl		
to 280ft Cap		
Rock utaw sand		
Water sand to		
400ft		

Information upon completion of well:

(1) Diameter 4 inches.

(2) Total Depth 400 feet.

(3) Water Level 90 feet below top of ground.

(4) Cased to 147, Size 4"

(5) Screen: Size _____, Length _____


(6) Were any formations sealed against pollution?
_____ yes, no.

If YES depth of formation _____

Why _____

Drillers Remarks: _____

148

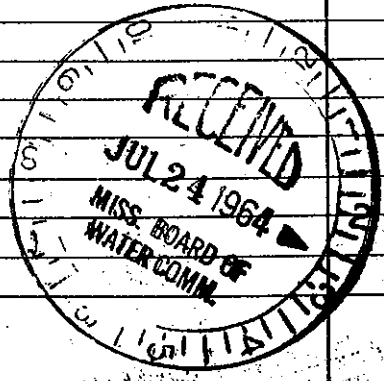

(Use Back Side)

Well No.

Mail this copy to Board of Water Commissioners 429 Miss. St. Jackson, Miss