

County: LEE
 Permit #: _____
 Driller: Parks & Parks
 Date drilling completed: 8/16/2004

State Well Report
Part 1 – Driller’s Log
 Mississippi Department of Environmental Quality
 Office of Land and Water Resources
 P.O. Box 2309
 Jackson, MS 39225
 (601)961- 5210
 (601)961- 5228 (fax)

For Office Use Only:

Aquifer: _____
 Well #: 4129
 L. S. Elevation: _____
 E-log #: _____

State Law requires that this report be prepared by the license holder responsible for the work and filed with the Department at the above address within 30 days of completion of drilling of the well or borehole.

Information on Well Owner <i>(Landowner if borehole is not for a water well)</i>	Well or Borehole Location
Owner Name <u>NORTH LEE WA TH #1</u>	Latitude: <u>34 20 05</u> Longitude: <u>88 38 09</u>
Mailing Address: _____	Method of Lat/Long (check one): Conventional Survey <input type="radio"/>
_____	USGS quad <input type="radio"/> Hand-held GPS <input checked="" type="radio"/> Survey-grade GPS <input type="radio"/>
_____	<u>NE</u> ¼ <u>NE</u> ¼ Sec <u>2</u> Twn <u>9S</u> Rng <u>6E</u>
City _____ State _____ Zip Code _____	Distance _____ Direction _____ Nearest Town _____
Telephone No. (____) _____	Miles _____ of _____

Well / Borehole Data

Date drilling started: _____ Date drilling completed: _____ Hole depth: 495 Hole diameter: 7.875

Location of the source of any surface water used for drilling: _____
 Method of dosing and volume of Chlorine used in drilling and development: _____

Logs run (check all applicable): None Electric Gamma Ray Density Sonic Neutron Other: _____
 Name of organization running log(s): MDEQ/OOG

Purpose of borehole (check one): Water Well Geotechnical/Geological Investigation Ground Source Heat Pump
 Seismic Survey Other (describe) TEST HOLE

If drilling is not related to water well construction, skip the remainder of this block

Purpose of Well (check one): Home Industrial Public Supply Irrigation Fish Culture Other: _____

If a flowing well, method of flow regulation: Valve Other (describe) _____

Static Water Level: _____ feet above or below (check one) land surface Date measured: _____

Method of Measurement (check one) steel tape electric tape air line other: _____

Well depth: 490 Well grouted to a depth of _____ feet Type of grout (check one): Neat Cement Bentonite Mix

Casing length: _____ feet Casing diameter: _____ inches Type of casing: _____

Screen length: _____ feet Screen diameter: _____ inches Type of screen: _____


Screen slot size: _____ inches Setting depth: From _____ feet to _____ feet


Type of completion (check all applicable): Gravel packed Underreamed Telescoped Open hole
 Natural Development Other (describe): _____

Top of lap pipe or reduction in casing: _____ feet. *If telescoped or more than one screen, describe on next page*

The sketch below only required for water wells

If well telescopes, show depths on sketch.

Ground Level 

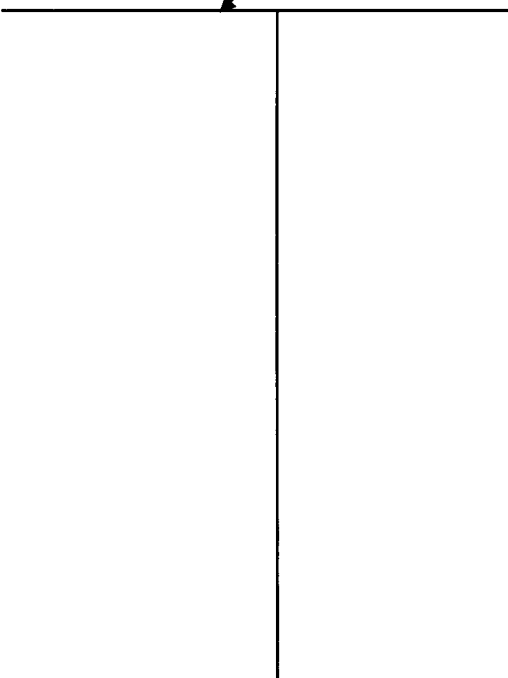

Description of formations encountered must be provided for all wells and boreholes, unless specifically exempted by regulations

Description of Formations Encountered	From (depth)	To (depth)
RED SAND	Ground Level	20
ROCKY	20	25
CLAY	25	70
RATTY SAND	70	110
CLAY	110	250
SAND AND CLAY	250	320
SAND	320	430
CLAY AND SAND	430	490

If more than one screen, show location of each on sketch

Sketch the property layout and include the following: 1) the well location; 2) any permanent structures on the property that may aid in locating the well; 3) any roads, power lines, or other items that may aid in locating the property and the well; 4) a north arrow.

Landowner Name: North Lee WA TH #1


Form: OLWR-SWR-1A (04/08)

I certify that the well/borehole was drilled, constructed, and completed in accordance with all applicable requirements of the Mississippi Department of Environmental Quality and the Mississippi Department of Health regulations, if applicable, and state laws.

Print Name of Responsible Licensee and License No.

Date

Signature of Licensee

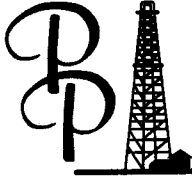

PARKS & PARKS WELL SERVICE, INC.

081 HC129

Post Office Box 32 • Houston, MS 38851

Water Well Contractors
Oil Field Services

PHONE: 662-456-2011
800-844-2011
FAX: 662-456-2284

August 30, 2004

North Lee Water Association
Lee County
Test Well #1
H - 129
Section - 2 / Township - 9S / Range - 6E

NE/NE SQ2 T9S R6E

34° 20' 05" 88° 38' 09"

8/16/04

7.875" bit

495' deep

0 - 20' Red Sand
20' - 25' Rocky
25' - 70' Clay
70' - 110' Ratty Sand
110' - 250' Clay
250' - 320' Sand & Clay
320' - 355' Sand
355' - 430' Sand
430' - 490' Clay & Sand

RECEIVED
DEC 26 2007
BY: OLWR