

County: LEE
 Permit #: _____
 Driller: Parks & Parks
 Date drilling completed: 10/5/2004

State Well Report

Part 1 – Driller’s Log

Mississippi Department of Environmental Quality
 Office of Land and Water Resources
 P.O. Box 2309
 Jackson, MS 39225
 (601)961- 5210
 (601)961- 5228 (fax)

For Office Use Only:
 Aquifer: _____
 Well #: H130
 L. S. Elevation: _____
 E-log #: _____

State Law requires that this report be prepared by the license holder responsible for the work and filed with the Department at the above address within 30 days of completion of drilling of the well or borehole.

Information on Well Owner (Landowner if borehole is not for a water well)	Well or Borehole Location
Owner Name: <u>NORTH LEE WA TH #2</u>	Latitude: <u>34 20 05</u> Longitude: <u>88 38 09</u>
Mailing Address: _____	Method of Lat/Long (check one): Conventional Survey <input type="radio"/>
_____	USGS quad <input type="radio"/> Hand-held GPS <input checked="" type="radio"/> Survey-grade GPS <input type="radio"/>
_____	<u>NE</u> ¼ <u>NE</u> ¼ Sec <u>2</u> Twn <u>9S</u> Rng <u>6E</u>
City _____ State _____ Zip Code _____	Distance _____ Direction _____ Nearest Town _____
Telephone No. (____) _____	Miles _____ of _____

Well / Borehole Data

Date drilling started: _____ Date drilling completed: _____ Hole depth: 582 Hole diameter: 7.875

Location of the source of any surface water used for drilling: _____
 Method of dosing and volume of Chlorine used in drilling and development: _____

Logs run (check all applicable): None Electric Gamma Ray Density Sonic Neutron Other: _____
 Name of organization running log(s): MDEQ/OOG

Purpose of borehole (check one): Water Well Geotechnical/Geological Investigation Ground Source Heat Pump
 Seismic Survey Other (describe) TEST HOLE

If drilling is not related to water well construction, skip the remainder of this block

Purpose of Well (check one): Home Industrial Public Supply Irrigation Fish Culture Other: _____

If a flowing well, method of flow regulation: Valve Other (describe) _____

Static Water Level: _____ feet above or below (check one) land surface Date measured: _____

Method of Measurement (check one) steel tape electric tape air line other: _____

Well depth: 580 Well grouted to a depth of _____ feet Type of grout (check one): Neat Cement Bentonite Mix

Casing length: _____ feet Casing diameter: _____ inches Type of casing: _____

Screen length: _____ feet Screen diameter: _____ inches Type of screen: _____

Screen slot size: _____ inches Setting depth: From _____ feet to _____ feet

Type of completion (check all applicable): Gravel packed Underreamed Telescoped Open hole
 Natural Development Other (describe): _____


Top of lap pipe or reduction in casing: _____ feet. *If telescoped or more than one screen, describe on next page*

The sketch below only required for water wells

Description of formations encountered must be provided for all wells and boreholes, unless specifically exempted by regulations

If well telescopes, show depths on sketch.

Ground Level →

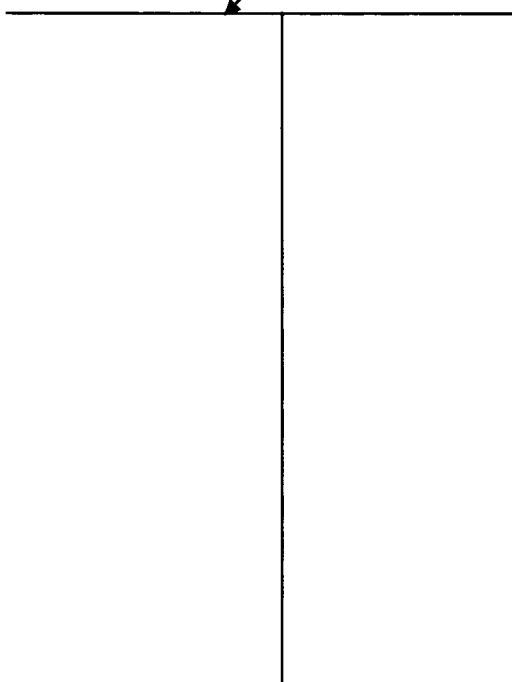

Description of Formations Encountered	From (depth)	To (depth)
SAND AND CLAY	Ground Level	30
CLAY	30	80
SAND AND CLAY	80	130
CLAY	130	290
SAND AND CLAY	290	330
CLAY	330	360
SAND	360	440
CLAY AND SAND	440	520
GRAVEL AND SAND	520	580

If more than one screen, show location of each on sketch

Sketch the property layout and include the following: 1) the well location; 2) any permanent structures on the property that may aid in locating the well; 3) any roads, power lines, or other items that may aid in locating the property and the well; 4) a north arrow.


Landowner Name: North Lee WA TH #2

Form: OLWR-SWR-1A (04/08)

I certify that the well/borehole was drilled, constructed, and completed in accordance with all applicable requirements of the Mississippi Department of Environmental Quality and the Mississippi Department of Health regulations, if applicable, and state laws.

_____ Date _____ Signature of Licensee

Print Name of Responsible Licensee and License No.

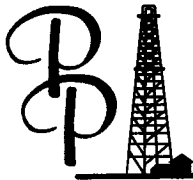

PARKS & PARKS WELL SERVICE, INC.

081H0130

Post Office Box 32 • Houston, MS 38851

Water Well Contractors
Oil Field Services

PHONE: 662-456-2011
800-844-2011
FAX: 662-456-2284

October 03, 2004

North Lee Water Association
Lee County
Test Well #2
H - 130
Section - 2 / Township - 9S / Range - 6E

0 - 30' Sand & Clay
30' - 80' Clay
80' - 130' Sand & Clay
130' - 290' Clay
290' - 330' Sand & Clay
330' - 360' Clay
360' - 440' Sand
440' - 520' Clay & Sand
520' - 580' Gravel & Sand

NE / NE S2 T9S R6E
34° 20' 05" 88° 38' 09"

582' deep

7.875" bit

10/05/04

RECEIVED
DEC 26 2007
BY: OLWR