

81

MISSISSIPPI DEPARTMENT OF ENVIRONMENTAL QUALITY

Office of Land and Water Resources

P. O. Box 10631

Jackson, MS 39289-0631

WATER WELL DRILLERS LOG

COUNTY WELL LOCATED
LEE

WELL NUMBER
H-131

CODED

DATE WELL COMPLETED
9-17-04

PERMIT NUMBER

NAME OF DRILLING FIRM
PAKKS & PAKKS WELL SERVICE

HOUSTON, MS 38857

NAME & MAILING ADDRESS OF LANDOWNER
Tupelo Fair Grounds Well #1

Tupelo, MS.

Latitude:

Longitude:

WELL LOCATION SEC TOWNSHIP RANGE
32 9 N 6 E

DISTANCE DIRECTION NEAREST TOWN

Miles of

OTHER LANDMARK

WELL PURPOSE: Home, Irrigation, Municipal, Industrial, Fish Pond, etc.

PUMP DATA

PUMP TYPE (Circle One):
Submersible Turbine, Jet, Flowing Well,
Other (Describe)

POWER TYPE (Circle One):
Electric Tractor, Diesel, Gasoline, Butane,
Other (Describe) **H/P 3**

DESCRIPTION OF FORMATIONS ENCOUNTERED	FROM	TO
SAND & CLAM	0	20
CLAY	20	120
CLAY + ROCK	120	125
CLAY	125	200
CLAY + ROCK	200	204
CLAY	204	280
CLAY + SAND	280	300
SAND	300	360

RECEIVED
OCT 13 2004
BY: OLWD
Top of Lap Pipe or Reduction in Casing
FEET IF TELESCOPED OR MORE THAN ONE SCREEN: USE BACK PAGE

WELL DATA

Well Depth 360	Casing Diameter (In.) 5	Casing Length (FL) 300
Type of Casing STEEL	Hole Depth 360	Depth to Static Water Level 125

TYPE OF COMPLETION: (Circle One or More):
Gravel Packed, Underreamed, Telescoped,
Natural Development, Open Hole, Other

WELL GROUTED TO A DEPTH OF **100** FEET
Type Grout (circle one): **Cement**, Bentonite, or Mix

SCREEN DATA


Diameter - inches 3	Length - Feet 60	Slot Size - inches .012
Screen Type S.S.	Depth to Bottom - Feet 360	

I certify that the well was drilled, constructed and completed in accordance with all applicable Requirements of the Mississippi Department of Environmental Quality and/or the Mississippi Department of Health regulations and state laws.

Rayburn Park 0-414
Signature of Licensed Driller and License No.

10/8/04
Date

If well telescopes please sketch and show depths.

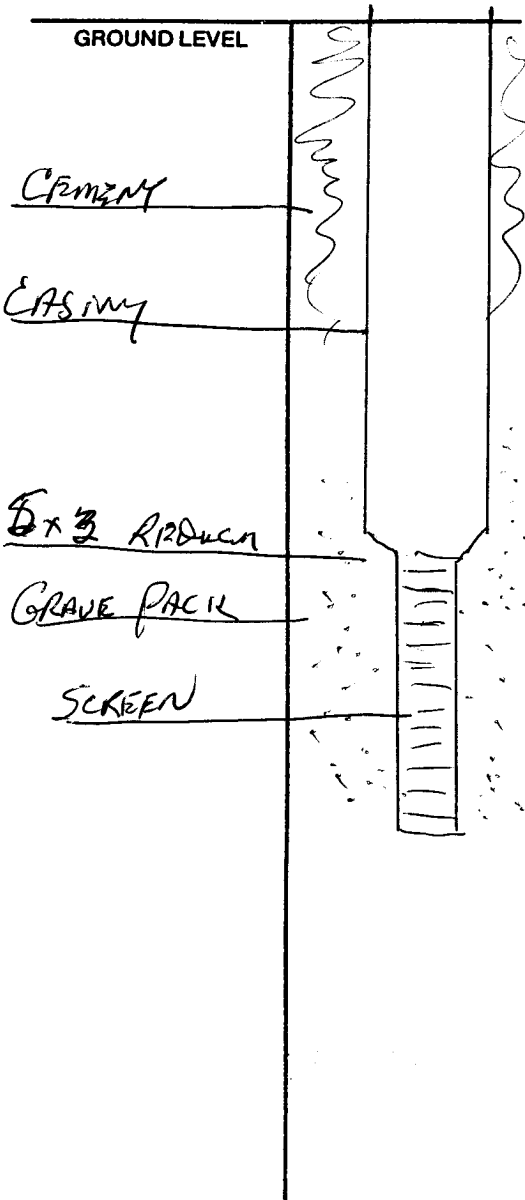

5 x 3 RIBBON

GRAVE PACK

SCREEN

	X		

SECTION 32

Please indicate well location X.

Pump Capacity (GPM)	No. of Stages	Setting Depth
40	9	168 FT.

PUMP TEST

Well yielded _____ GPM with
a drawdown of _____ ft.
after _____ hours of pumping

LOG DATA

TYPE OF LOG RUN (Circle One): No Log Run
Electric, Gamma Ray, Density, Sonic, Neutron,
Other (Describe) _____

Name of Organization Running Log _____

GEOLOGIC DATA (Office Use Only)

Surface Elev.	Geologic Unit	Unit Thickness	Depth to Top
Subs. SWL	Date	Analysis	Aquifer Test

Driller's Remarks

If more than one screen,
show location of each on sketch.