
STATE WELL REPORT	
County: Le~ Part 1	For Office Use Only:
Duillouis Log	Well #: 11142
Mississippi Department of Environmental Quality	y Aquifer:
Driller: Donald Snith Co. Office of Land and Water Resources P.O. Box 2309	E-Log #:
Date drilling completed: 50313 Jackson, MS 39225-2309	
(601)961-5210 (601)360-0535 (fax)	
State Law requires that this report be prepared by the licensc holder responsible for Department at the above address within 30 days of completion of drilling of the we	r the work and filed with the Il or borehole.
Well Owner Information Well or Bo	orehole Location
(Landowner if borehole is not for a water well) Latitude: <u>34</u> 1852NL	_ongitude: <u>88 41 03W</u>
Owner Name: <u>JSLLC</u>	one): Conventional Survey,
Mailing Address: 3515 10m Walsun Ur	IGPS <u>X_</u> , Survey-grade GPS
Saltillo MS 38866 NW 4 SW 4, se	<u>c_9¹/T_95 R_6</u> E
	of Typels, MS
Telephone No. () (Distance) (Direction)	
Well / Borehole Data	
Date drilling started: 50313 Date drilling completed: 53113 Hole depth: 40	Hole diameter: <u>15"</u>
Location of the source of any surface water used for drilling: <u>Public Water</u>	Supply
Method of dosing and volume of Chlorine used in drilling and development: <u>Potabl</u>	e Water Used
Logs run (circle all applicable): No log run Electric Gamma Ray Density Sonic Neu	Itron Other:
Name of organization running log(s): MS Office of Geology	
Purpose of borehole (circle one) Water Well Geotechnical/Geological Investigation	Ground Source Heat Pump
Seismic Survey Other (describe)	ي ۵. مېر د
If drilling is not related to water well construction, skip the remain	der of this block RECEIVE
Purpose of Well (circle all applicable): Home Industrial Public Supply Irrigation	Fish Culture JUN 2 8 2015
Other (describe): farm Commercial	RY OLW
If a flowing well, method of flow regulation: Valve Other (<i>describe</i>)	989
Static Water Level: <u>92.8</u> feet [above or <u>Delow</u>] land surface Date measu (circle one)	ired: <u>5 30 13</u>
Method of measurement (circle one): Steel tape Electric tape Air line Other (describ	be):
Well depth: 408 Well grouted to a depth of: 322 feet Type of grout (<i>circle or</i>	
Casing length: <u>322</u> feet Casing diameter: <u>8</u> inches Type	
Screen length:feet Screen diameter:inches Type	
Screen slot size: <u>. 020</u> inches Setting depth: From <u>321</u> feet 3にフー 389- 81	t to 367 feet lauk 389-408 Screen
Type of completion (circle all applicable): Gravel packed Underreamed Open ho	ole Natural Development
Other (describe):	RECEIVER
Top of lap pipe or reduction in casing: 267 feet If telescoped or more than one screen, describe on next	

2

3,	¥	•	, e ^{re} **	į	V	-	
×				÷	1.0	A	

Lee County: Permit #: MS-GW-17058

	For	Office Use Only:	
Well	#:	H142	

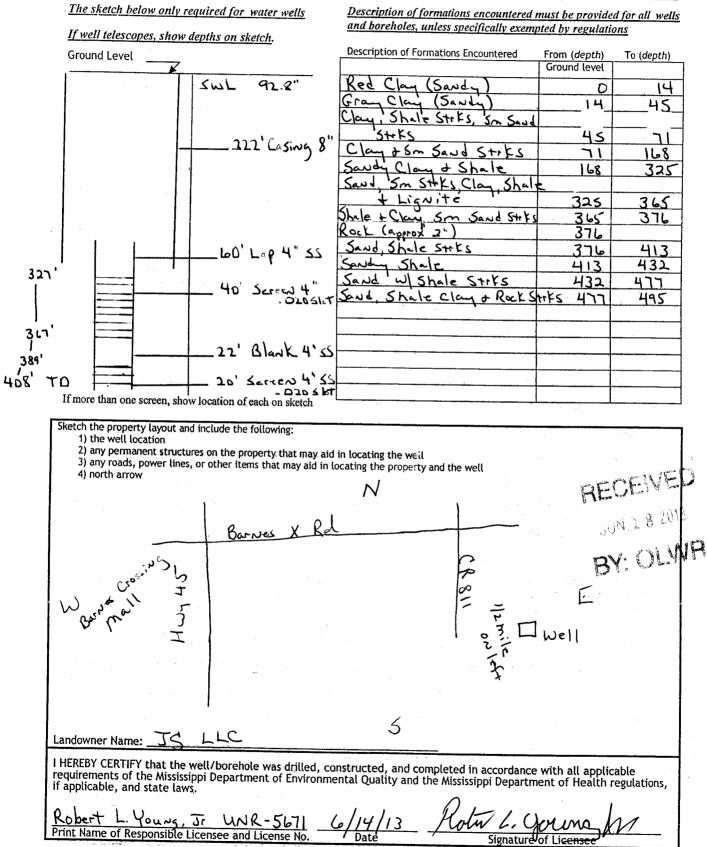

Form: OLWR-SWR-1A (4/13)

	STATE WELL REPORT	
County: Lee	Part 2	For Office Use Only:
Permit #: <u>ms-Gw-17058</u>	Pump Installer's Completion Report Mississippi Department of Environmental Quality	Well #:
Driller: Donald Smith Co.	Office of Land and Water Resources	:
Date completed: 71513	P.O. Box 2309 Jackson, MS 39225-2309	Aquifer:
Copy information from block on Part 1	(601)961-5210 (601) 360-0535 (fax)	
	ed by a licensed water well contractor or a licensed pu	
of the report must be attached and both Well Owner Informati	parts filed with the Department at the above address	<i>within 30 days of well completion.</i> Location
Owner Name: JS LLC		ongitude: 88 41 03W
Mailing Address: 3575 Tom		e): Conventional Survey,
	USGS quad, Hand-held (
Saltillo MS		<u>9</u> T <u>95</u> <u>R</u> <u>6</u>
City State	7ip Code	
Telephone No. ()	Miles <u>N</u> (Distance) (Direction)	of <u>Ingelo</u> , In <u>S</u> (Nearest Town)
······································	Pump Type (circle one)	
Submersible Turbine Air Lift Centrif	ugal Flowing Well Jet Piston Rotary Other (a	lescribe):
Date Pump Installed:61911.	3 Rated Pump Capacity:	50Gallons Per Minute
Is This Pump (circle one): (New) Rep	paired Replacement	
<u> </u>	Power Type (circle one)	
Electric) Diesel Gasoline Natural Gas	Tractor PTO Windmill Other (<i>describe</i>):	
Horse Power Rating of Motor:	Setting Depth:feet Number	er of Stages:
······································	Pump Test Data for Non Flowing Well	
	Duration of Pump Test (mini	mum 4 hours): hours
Static Water Level (A): 92.8 Fee	t Below Land Surface Pumping Water Level (B):	23.74 Feet Below Land Surface
Drawdown [(B) - (A)]: <u>30.94</u>	_Feet Below Land Surface Test Pumping Rate:	110 Gallons Per Minute
Method of measurement (circle one): S	teel tape Electric tape Air line Other (describe)	
	Pump Test Data for Flowing Well	
Measured shut in head:feet	t.	
Well yielded GPM with a	drawdown of feet after	hours of pumping
	Meter Installation	<u>(</u> ')
Meter Manufacturer:	A Meter Serial Number: _	RE
	Type of Meter:	ł
Meter Model Number/Name:	actor (AF x .001, gal x 1000, etc):	
Meter Model Number/Name: Totalizer Register Unit and Multiplier F		BY
Totalizer Register Unit and Multiplier F	Meter installed by:	
Totalizer Register Unit and Multiplier F	Meter installed by:	
Totalizer Register Unit and Multiplier F Installation Date: Is This Meter (circle one): New Re Important: By submitting the above in	Meter installed by:	alled to manufacturer standards.
Totalizer Register Unit and Multiplier F Installation Date: Is This Meter (circle one): New Re Important: By submitting the above in For agricultu	Meter installed by: paired Replacement nformation you are certifying that this meter was inst	alled to manufacturer standards.