

MISSISSIPPI BOARD OF WATER COMMISSIONERS

LEE  
H 2000  
7-1-60

WATER WELL DRILLERS LOG

FWI GAS Co.

Date: 7-1, 1960, Driller: JAMES FOWLER County LEE

(Name)

(1) Owner of Land:	Description & Color of Materials Sand, Clay, Red Clay, Shell, etc.	Thick- ness Feet	Depth Feet
(Name) <u>ALBERT MONROE</u> (Address) <u>SARITTO, MISS.</u>	<u>Joint Clay</u>	<u>0</u>	<u>40</u>
(2) Location: <u>1/4</u> , <u>1/4</u> , Sec. <u>25 956E</u> T R <u>WTWU TV 50th</u> <u>1</u> miles <u>N</u> of <u>Old My 45</u> (distance) (direction) (Nearest Town)	<u>Sand &amp; Limestone</u>	<u>40</u>	<u>108</u>
(3) Topography: _____ (Hilly) (Flat) (Level)	<u>Blue clay</u>	<u>108</u>	<u>300</u>
(4) Purpose of Well: <u>Household</u> (Domestic Irrigation Municipal, Industrial, Other)	<u>Sand</u>	<u>300</u>	<u>404</u>


Information upon completion of well:

- (1) Diameter 4 inches.
- (2) Total Depth 404 feet.
- (3) Water Level TV feet below top of ground.
- (4) Cased to 108', Size 4"
- (5) Screen: Size 0, Length \_\_\_\_\_
- (6) Were any formations sealed against pollution?  
 yes,  no.

If YES depth of formation 108'

Why \_\_\_\_\_

Drillers Remarks: \_\_\_\_\_

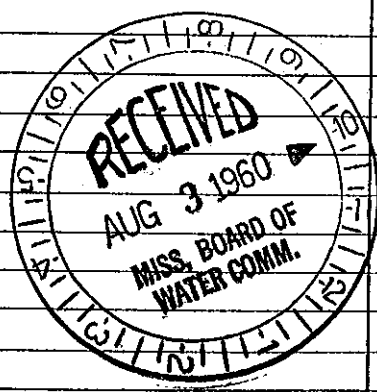

55

Well No.

(Use Back Side)

Mail this copy to Board of Water Commissioners 429 Miss. St. Jackson. Miss