

LEG

MISSISSIPPI BOARD OF WATER COMMISSIONERS

J 13

WATER WELL DRILLERS LOG

8-9-60

Date: 8-9, 1960, Driller: O. C. Webb County Lee

(Name)

(1) Owner of Land: Moorsville School (Name)

Moorsville Miss (Address)


(2) Location: 1/4, 1/4, Sec. 28, T. 9 R. 7

1/4 miles north of Moorsville (distance) (direction) (Nearest Town)

(3) Topography: (Hilly) (Flat) (Level)

(4) Purpose of Well: School well (Domestic Irrigation, Municipal, Industrial, Other)

Description & Color of Materials Sand, Clay, Red Clay, Shell, etc.	Thick- ness Feet	Depth Feet
Soil to 19 ft		
Blue Rock to 180 ft		
sand water		
Barri to 350 ft		

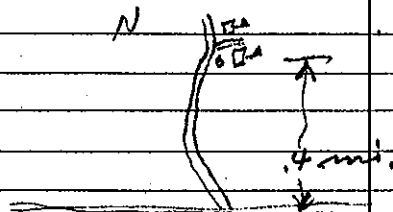

Information upon completion of well:

(1) Diameter: 6 inches.

(2) Total Depth: _____ feet.

(3) Water Level: _____ feet below top of ground.

(4) Cased to 216, Size 6 in

(5) Screen: Size 4", Length 42 ft

(6) Were any formations sealed against pollution?


yes, no.

If YES depth of formation _____

Why _____

Drillers Remarks: _____

154 ELEV 405

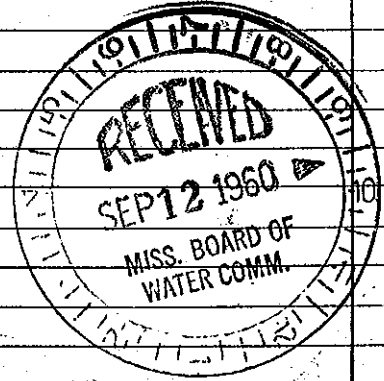

(Use Back Side)

Well No. J301

Mail this copy to Board of Water Commissioners 429 Miss. St. Jackson, Miss