
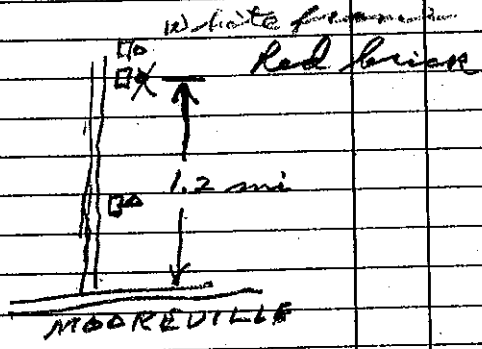


WATER WELL DRILLERS LOG

LEE
J 14
Date: 11-17-, 1960, Driller: Ewing Garla County, Lee
11-17-60 (Name)

(1) Owner of Land:	Description & Color of Materials Sand, Clay, Red Clay, Shell, etc.	Thick- ness Feet	Depth Feet
BLUEFORD MOUNT <u>Guster Mitchell</u> (Name) <u>Mooreville, Miss.</u> (Address)			
(2) Location: <u>1/4</u> , <u>1/4</u> , Sec. <u>20 T9 R7</u> <u>5</u> <u>E</u> miles _____ of _____ (distance) (direction) (Nearest Town)			
(3) Topography: _____ (Hilly) (Flat) (Level)			
(4) Purpose of Well: <u>Household</u> (Domestic Irrigation Municipal, Industrial, Other)			
Information upon completion of well:			
(1) Diameter <u>4</u> inches.			
(2) Total Depth <u>308</u> feet.			
(3) Water Level <u>138</u> feet below top of ground.			
(4) Cased to <u>43'</u> , Size _____			
(5) Screen: Size _____, Length _____			
(6) Were any formations sealed against pollution? <input checked="" type="checkbox"/> yes, _____ no.			
If YES depth of formation <u>43'</u>			
Why _____			
Drillers Remarks: <u>Copland</u>			
<u>157 V IELEU 418</u> <u>425</u>			

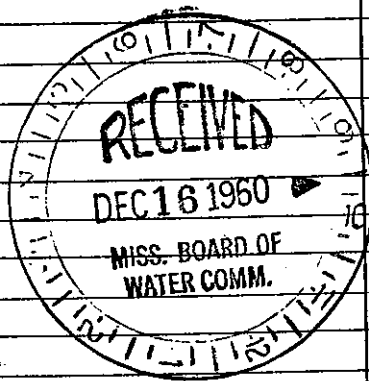

(Use Back Side)

Well No.

Mail this copy to Board of Water Commissioners 429 Miss. St. Jackson, Miss