

MISSISSIPPI BOARD OF WATER COMMISSIONERS

WATER WELL DRILLERS LOG  
HERNDON WELL & SUPPLY CO.


LEE  
J 15  
3-8-63

Date: March 6, 1963, Driller: SHANNON, MISSISSIPPI P.O. BOX 42 County Lee

	Description & Color of Materials Sand, Clay, Red Clay, Shell, etc.	Thick- ness Feet	Depth Feet
(1) Owner of Land: <u>Jesse Wallace</u> (Name) <u>Moosville Miss</u> (Address)	<u>surface sand</u>		<u>0</u>
(2) Location: $\frac{1}{4}$ , $\frac{1}{4}$ , Sec <u>33</u> T <u>9S</u> R <u>7E</u> <u>1/2</u> miles <u>S</u> , of <u>Moosville</u> (distance) (direction) (Nearest Town)	<u>clay</u> <u>blue shale</u> <u>ground</u>		<u>34</u> <u>140</u>
(3) Topography: <u>Flat</u> (Hilly) (Flat) (Level)	<u>Bottom</u>		<u>300</u>
(4) Purpose of Well: <u>Domestic</u> (Domestic Irrigation Municipal, Industrial, Other)			

Information upon completion of well:

- (1) Diameter 5 inches.
- (2) Total Depth 300 feet.
- (3) Water Level 115 feet below top of ground.
- (4) Cased to 37', Size 5"
- (5) Screen: Size —, Length —
- (6) Were any formations sealed against pollution?  
 yes,  no.
- If YES depth of formation 34'
- Why surface sand
- Drillers Remarks: See

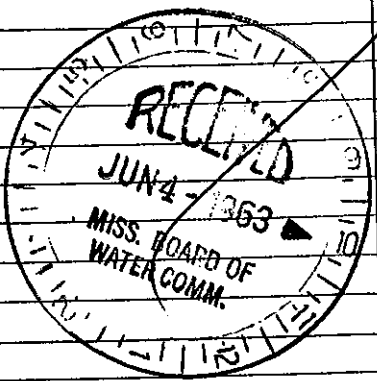

174 ELEV 390

(Use Back Side)

Well No.

Mail this copy to Board of Water Commissioners 429 Miss. St. Jackson, Miss.