

LEE
J 16
8-2-62

MISSISSIPPI BOARD OF WATER COMMISSIONERS

WATER WELL DRILLERS LOG

Date: Aug 2, 1962, Driller: HERNDON WELL & SUPPLY CO. County Lee
P. O. BOX 42
SHANNON, MISSISSIPPI

	Description & Color of Materials Sand, Clay, Red Clay, Shell, etc.	Thick- ness Feet	Depth Feet
(1) Owner of Land: <u>James Smith</u> (Name)	<u>Sand & clay</u>		<u>0</u>
Pt 2 <u>Dorsey, Miss</u> (Address)	<u>of</u>		
(2) Location: <u>1/4, 1/4, Sec 15 957E</u> T R	<u>Blue sand</u>		<u>30</u>
<u>1/2</u> miles <u>NE</u> of <u>Mooreville</u> (distance) (direction) (Nearest Town)	<u>Sand</u>		<u>140</u>
(3) Topography: <u>Flat</u> (Hilly) (Flat) (Level)	<u>Bottom</u>		<u>300</u>
(4) Purpose of Well: <u>Domestic</u> (Domestic Irrigation Municipal, Industrial, Other)			


Information upon completion of well:

- (1) Diameter 4 inches.
- (2) Total Depth 300 feet.
- (3) Water Level 100 feet below top of ground.
- (4) Cased to 33' 3" Size 4"
- (5) Screen: Size , Length .
- (6) Were any formations sealed against pollution?
 yes, no.

If YES depth of formation 30'

Why Sand & Sand

Drillers Remarks:

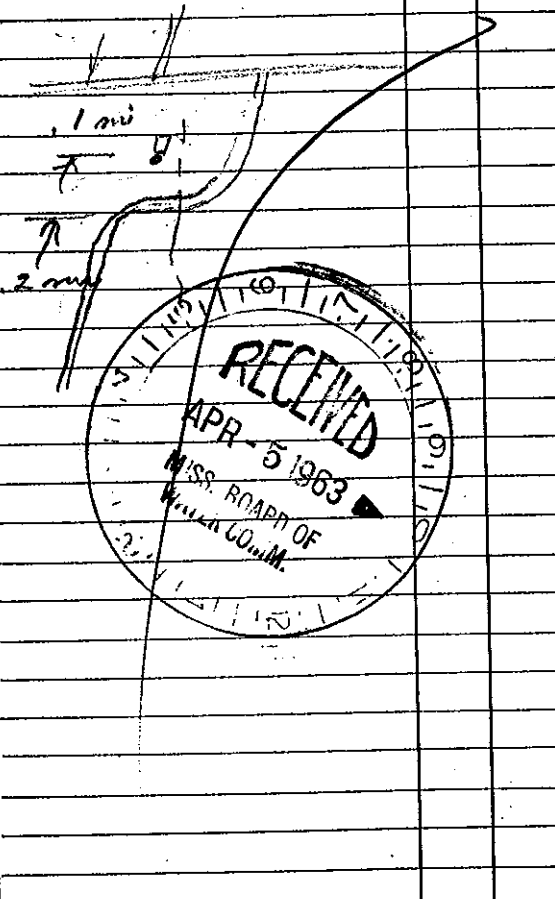

173 ELEV 390

(Use Back Side)

Well No.