

LEE
J 17
6-12-62

MISSISSIPPI BOARD OF WATER COMMISSIONERS

WATER WELL DRILLERS LOG
HERNDON WELL & SUPPLY CO.

Date June 12, 1962, Driller: SHANNON HALL P. O. BOX 42
MISSISSIPPE County Lee
(Name)

Contracted		Description & Color of Materials Sand, Clay, Red Clay, Shell, etc.	Thick- ness Feet	Depth Feet
(1) Owner of Land: <u>James Smith</u> (Name)		<u>sand & clay</u>	<u>8</u>	<u>0</u>
<u>Rt</u> (Address)		<u>Blue rock</u>	<u>8</u>	<u>35</u>
(2) Location: <u>15/29 9876</u> 1/4, 1/4, Sec <u>15</u> , T. <u>15</u> , R. <u>76</u>		<u>sand</u>	<u>8</u>	<u>140</u>
<u>1</u> miles <u>E</u> , of <u>Marvell</u> (distance) (direction) (Nearest Town)		<u>Bottom</u>	<u>371</u>	<u>260</u>
(3) Topography: <u>Hilly</u> (Hilly) (Flat) (Level)		<u>3 mi</u>		
(4) Purpose of Well: <u>Domestic</u> (Domestic Irrigation Municipal, Industrial, Other)				

Information upon completion of well:



- (1) Diameter 4 inches.
- (2) Total Depth 260 feet.
- (3) Water Level 130 feet below top of ground.
- (4) Cased to 371, Size 4".
- (5) Screen: Size —, Length —.
- (6) Were any formations sealed against pollution?
 yes, no.

If YES depth of formation 35'

Why Surface & SAND

Drillers Remarks:

170 ELEV 400

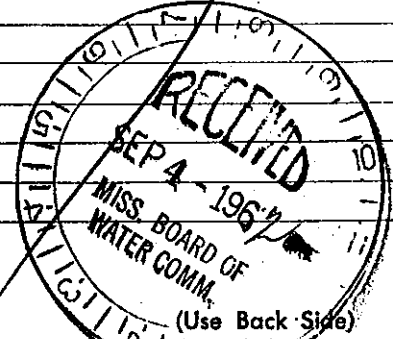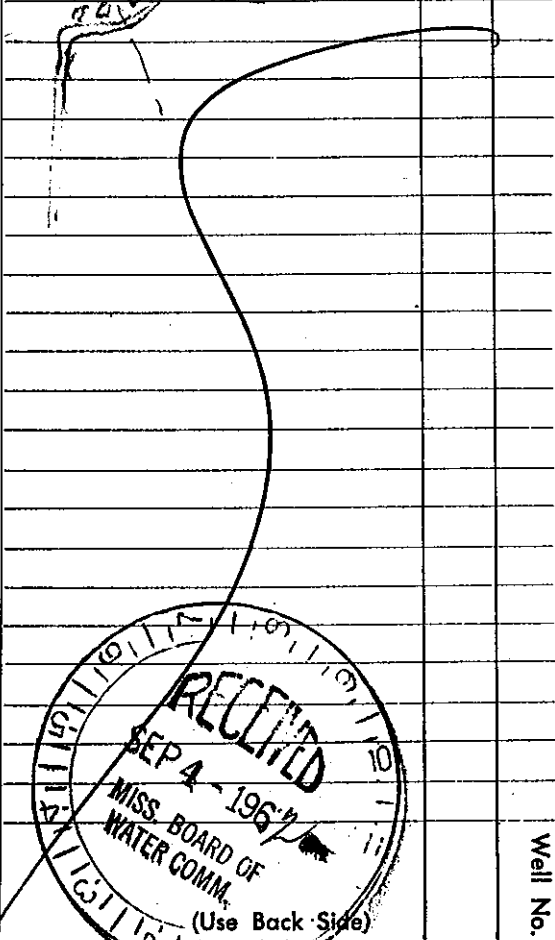

Well No.

Mail this copy to Board of Water Commissioners, 229 Miss. St. Jackson, Miss.