

MISSISSIPPI BOARD OF WATER COMMISSIONERS

LEE  
J 19  
5-30-61

WATER WELL DRILLERS LOG

HERNDON WELL & SUPPLY CO.

Date: May 30, 1961, Driller: SHANNON P. O. BOX 42 County: Lee  
Name: MISSISSIPPI

(1) Owner of Land:	Description & Color of Materials Sand, Clay, Red Clay, Shell, etc.	Thick- ness Feet	Depth Feet
(Name) <u>C.C. Harris</u> (Address) <u>Moenville, Miss</u>	<u>Surface sand</u> <u>+ clay</u>		<u>0</u>
(2) Location: <u>1/4</u> , <u>1/4</u> , Sec <u>10</u> T <u>9S</u> R <u>2E</u> <u>4</u> miles <u>NE</u> of <u>Moenville</u> (distance) (direction) (Nearest Town)	<u>Blue rock</u> <u>S</u>	<u>38</u>	
(3) Topography: <u>Hilly</u> (Hilly) (Flat) (Level)	<u>Sand</u>	<u>220</u>	
(4) Purpose of Well: <u>Home use</u> (Domestic Irrigation, Municipal, Industrial, Other)	<u>Bottom</u>	<u>340</u>	

Information upon completion of well:


- (1) Diameter 4 inches.
- (2) Total Depth 340 feet.
- (3) Water Level 180 feet below top of ground.
- (4) Cased to 41' 2", Size 4"  
63', Size 2 1/2"
- (5) Screen: Size 1 47', Length 2"
- (6) Were any formations sealed against pollution?  
 yes,  no.

If YES depth of formation 38'

Why Surface + Sand

Drillers Remarks:

159 ELEV 430

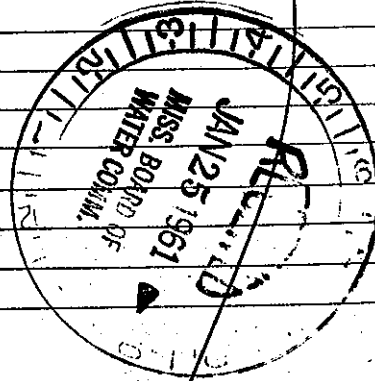

(Use Back Side)

Well No.