

MISSISSIPPI BOARD OF WATER COMMISSIONERS

LEE


J 20


5-31-61

WATER WELL DRILLERS LOG

HERNDON WELL & SUPPLY CO.

Date: May 31, 1961, Driller: HERNDON WELL & SUPPLY CO. P.O. BOX 42 County Lee  
 SHANNON, MISSISSIPPI

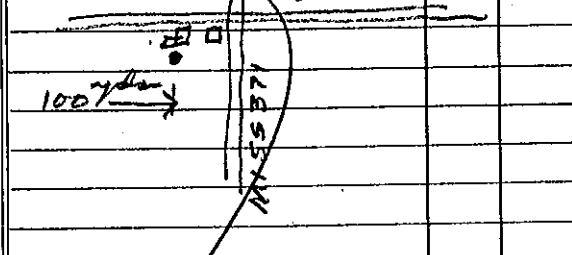	Description & Color of Materials Sand, Clay, Red Clay, Shell, etc.	Thick- ness Feet	Depth Feet
(1) Owner of Land: <u>J. E. Gray</u> (Name) <u>Merriwell, Miss.</u> (Address)	<u>Surface sand</u> <u>&amp; clay</u>		<u>0</u>
(2) Location: <u>1/4, 1/4, Sec 28 T 9 S R 16 E</u> <u>0</u> miles <u>—</u> of <u>Merriwell</u> (distance) (direction) (Nearest Town)	<u>Blue rock</u> <u>to</u> <u>gravel</u>	<u>33</u>  <u>200</u>	
(3) Topography: <u>Hilly</u> (Hilly) (Flat) (Level)	<u>to</u> <u>Bottom</u>		<u>320</u>
(4) Purpose of Well: <u>Domestic</u> (Domestic Irrigation Municipal, Industrial, Other)			
Information upon completion of well:			
(1) Diameter <u>4</u> inches.			
(2) Total Depth <u>320</u> feet.			
(3) Water Level <u>150</u> feet below top of ground.			
(4) Cased to <u>35' 4"</u> , Size <u>4"</u>			
(5) Screen: Size <u>—</u> , Length <u>—</u>	<u>3/4 HP Cylinder pump</u> <u>specific sand 300</u>		
(6) Were any formations sealed against pollution? <input checked="" type="checkbox"/> yes, <input type="checkbox"/> no.			
If YES depth of formation <u>33'</u>			
Why <u>Surface &amp; sand</u>			
Drillers Remarks: <u>Used car lot</u> <u>and Gray's Grocery</u>			
<u>160 ELEV 400</u>			

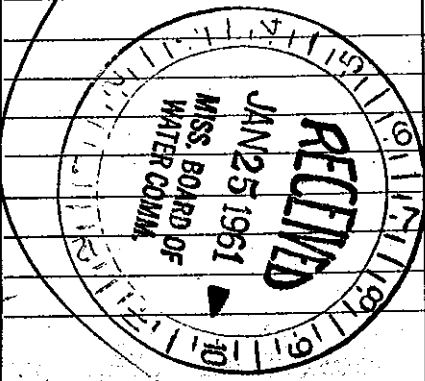

(Use Back Side)

Well No.

Mail this copy to Board of Water Commissioners 429 Miss. St. Jackson, Miss