

MISSISSIPPI BOARD OF WATER COMMISSIONERS

LEE
J 21
6-24-61

WATER WELL DRILLERS LOG
HERNDON WELL & SUPPLY CO.

Lee
1304



Date: June 24 1961, Driller: P. O. BOX 42 County Lee
SHANNON, MISSISSIPPI

(1) Owner of Land:	Description & Color of Materials Sand; Clay, Red Clay, Shell, etc.	Thick- ness Feet	Depth Feet
<u>J. V. Morgan</u> (Name) <u>Mooreville, Miss</u> (Address)	<u>sand & clay</u>	0	0
(2) Location: <u>27</u> <u>99 7/8</u> <u>T R 7E</u> <u>27</u> miles <u>north</u> , of <u>Mooreville</u> (distance) (direction) (Nearest Town)	<u>Blue rock</u>	30	30
(3) Topography: <u>Hilly</u> (Hilly) (Flat) (Level)	<u>sand</u>	6	120
(4) Purpose of Well: <u>Domestic</u> (Domestic Irrigation Municipal, Industrial, Other)	<u>Bottom</u>	240	240

Information upon completion of well:

- (1) Diameter 4 inches.
- (2) Total Depth 240 feet.
- (3) Water Level 90 feet below top of ground.
- (4) Cased to 36' 6", Size 4"
- (5) Screen: Size , Length
- (6) Were any formations sealed against pollution?
 yes, no.

If YES depth of formation 30 ft
Why Silt & Sand
Drillers Remarks:

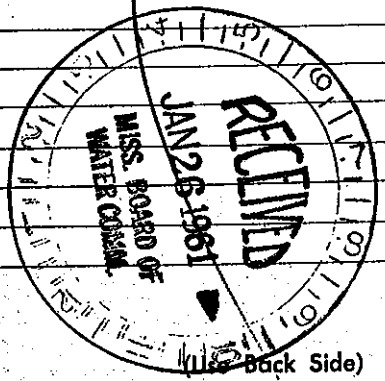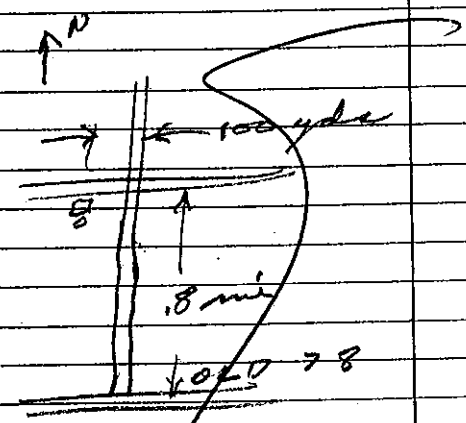

Well No.

162 ELRU 355

Mail this copy to Board of Water Commissioners 429 Miss. St. Jackson, Miss