


LEE
J 23

MISSISSIPPI BOARD OF WATER COMMISSIONERS

WATER WELL DRILLERS LOG

Date: 9/23, 1966, Driller: Ewing Basco County Dea
(Name)

(1) Owner of Land	Description & Color of Materials Sand, Clay, Red Clay, Shell, etc.	Thick- ness Feet	Depth Feet
<u>John B. Mullins</u> (Name) <u>Mooreville Rt 1</u> (Address)	<u>Light Clay</u> <u>Blue</u> <u>Sand</u>	<u>30</u> <u>127</u> <u>130</u>	<u>30</u> <u>159</u> <u>288</u>
(2) Location: $\frac{1}{4}$, $\frac{1}{4}$, Sec. <u>33 T9 R7E</u> <u>MOOREVILLE US 79</u>			
<u>1</u> miles <u>S</u> , of <u>Mooreville</u> (distance) (direction) (Nearest Town)			
(3) Topography: <u>Hilly</u> (Hilly) (Flat) (Level)			
(4) Purpose of Well: <u>Domestic</u> (Domestic Irrigation Municipal, Industrial, Other)			
Information upon completion of well:			
(1) Diameter <u>4</u> inches.			
(2) Total Depth <u>283</u> feet.			
(3) Water Level <u>110</u> feet below top of ground.			
(4) Cased to <u>35 ft</u> , Size <u>4 in.</u>			
(5) Screen: Size _____, Length _____			
(6) Were any formations sealed against pollution? _____ yes, _____ no.			
If YES depth of formation _____			
Why _____			
Drillers Remarks: <u>old house</u> <u>and house trailer</u>			
<u>349 ELEV 390</u>			

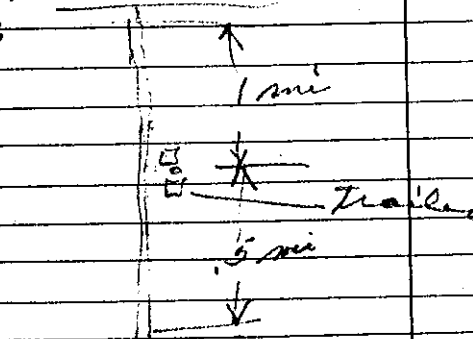

(Use Back Side)

Well No.