

LEE MISSISSIPPI BOARD OF WATER COMMISSIONERS

J 26

WATER WELL DRILLERS LOG

5-11-62

Date: 5/11, 1962, Driller: James Faulkner County, Lee
(Name)

	Description & Color of Materials Sand, Clay, Red Clay, Shell, etc.	Thick- ness Feet	Depth Feet
(1) Owner of Land: <u>James M. Coyle</u> (Name) <u>Rt. 1 Moorville</u> (Address)			
(2) Location: <u>1/4, 1/4, Sec. 21 T9 R7</u> <u>12</u> miles <u>N</u> of <u>Moorville</u> (distance) (direction) (Nearest Town)			
(3) Topography: <u>Hilly</u> (Hilly) (Flat) (Level)			
(4) Purpose of Well: <u>DOMESTIC</u> (Domestic Irrigation Municipal, Industrial, Other)			


Information upon completion of well:

- (1) Diameter 4" inches.
- (2) Total Depth 224' feet.
- (3) Water Level 70' feet below top of ground. 78.0 3/22/67
- (4) Cased to 21'-6", Size 4"
- (5) Screen: Size _____, Length _____
- (6) Were any formations sealed against pollution?
_____ yes, _____ no.

If YES depth of formation _____

Why _____

Drillers Remarks: _____

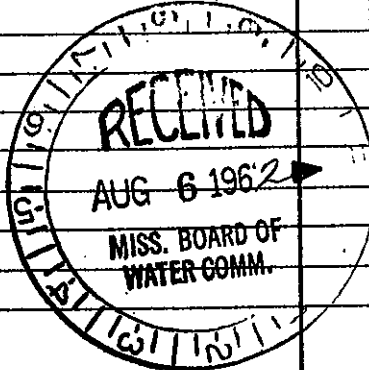

167 ELEV 341

(Use Back Side)

Well No.