

Lee  
J27  
1-67

MISSISSIPPI  
BOARD OF WATER COMMISSIONERS  
416 North State Street  
Jackson, Mississippi 39201

WATER WELL DRILLERS LOG  
Herndon-Homan Well & Supply, Inc.

Jan 13 1967 date well completed  
P. O. Box 42 Lee  
SHANNON, MISSISSIPPI 38868 county well located


LANDOWNER: Leo Keith  
Moorseville, Miss (mailing address)

description of formations encountered	from	to
surface sand & clay	0	28
blue clay	28	110
blue sand	110	120
blue clay	120	200
sand	200	320
bottom	320	

WELL LOCATION:  
sec. 229 N R 7 E S  
1 1/2 miles (distance) N of Moorseville (direction) (nearest town)

WELL PURPOSE: home  
(home, irrigation, municipal, industrial)

WELL COMPLETION DATA:  
(1) diameter (inches) 5"  
(2) total depth (feet) 320  
(3) static water level (feet) 15' below top of ground.  
(4) casing steel 32' 7" (material) (depth)  
If telescope see back.  
(5) screen NO (length) (depth to top)  
(size) (material)  
(6) pump 3/4 (HP) 5 (yield gpm)  
electric (type power)  
(7) electric log NO (yes or no)  
(organization running log)  
(8) how well bottom plugged open

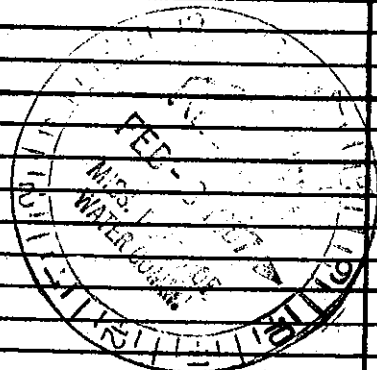

DRILLERS REMARKS:  
380 FEET YR 2