

LEE MISSISSIPPI BOARD OF WATER COMMISSIONERS

J 28

6-9-62

WATER WELL DRILLERS LOG

Date: 6/19, 1962, Driller: James Fowler County: Lee

(1) Owner of Land: <u>Jack Sandale</u> (Name) <u>R.T. 2. Zupelo</u> (Address)	Description & Color of Materials Sand, Clay, Red Clay, Shell, etc.	Thick- ness Feet	Depth Feet
(2) Location: <u>1/4, 1/4, Sec. 21 T9 R7,</u> <u>1 1/2</u> miles <u>NE</u> of <u>Monroe</u> (distance) (direction) (Nearest Town)			
(3) Topography: <u>Hilly</u> (Hilly) (Flat) (Level)			
(4) Purpose of Well: <u>Domestic</u> (Domestic Irrigation Municipal, Industrial, Other)			


Information upon completion of well:

- (1) Diameter: 4" inches.
- (2) Total Depth: 273' feet.
- (3) Water Level: 70' feet below top of ground.
- (4) Cased to: 21', Size: 4"
- (5) Screen: Size _____, Length _____.
- (6) Were any formations sealed against pollution?
_____ yes, _____ no.

If YES, depth of formation _____

Why _____

Drillers Remarks: _____

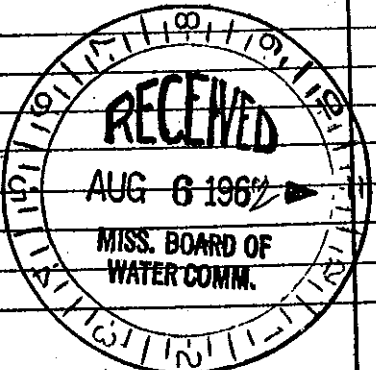

(Use Back Side)

Well No.

169 ELEV 348

Mail this copy to Board of Water Commissioners 429 Miss. St. Jackson, Miss.