

MISSISSIPPI BOARD OF WATER COMMISSIONERS

WATER WELL DRILLERS LOG

Lee
 J30 Coded
 5-67

Date: 5-25, 1967, Driller: Herndon-Homan Well & Supply, Inc. County Lee
 (When well drilled) P. O. Box 42 (Where well is located)
 SHANNON, MISSISSIPPI 38868


1) Owner of Land:	Description & Color of Materials	Thick-ness Feet	Depth Feet
<u>Laverace Edwards</u> (Name)	Sand, Clay, Red Clay, Shell, etc.		
<u>At Mooreville Miss</u> (Address)	<u>surface sand & clay</u>	<u>0 - 40</u>	<u>40 - 200</u>
<u>SW 5/4</u> (Address)	<u>blue clay</u>	<u>40 - 200</u>	<u>200 - 320</u>
<u>1/4, Sec. 19, T. 9 S., R. 7 E.</u> (Location)	<u>Bottom</u>	<u>320</u>	
<u>2 1/2 miles NW</u> (distance) (direction) (Nearest Town)			
<u>Hilly</u> (Topography) (Hilly) (Flat) (Level)			
<u>Home</u> (Purpose of Well) (Domestic Irrigation) (Municipal, Industrial, Other)			

Information upon completion of well:

- (1) Diameter 5 inches.
- (2) Total Depth 320 feet.
- (3) Water Level 125 feet below top of ground.
- (4) Cased to 42' 4", Size 5".
- (5) Screen: Size NONE, Length _____.
- (6) Were any formations sealed against pollution?
 yes, _____ no.

If YES depth of formation 40'
 Why surface & sand
 Drillers Remarks:
 Yield in gpm: 5
 Size pump: 1/2 HP Sub.
 Type power: Electric

Coded

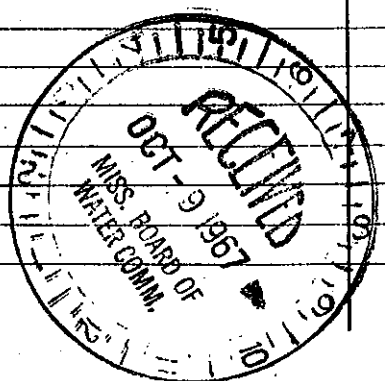

Retain this copy for your office files.