

Lee
J 34

MISSISSIPPI BOARD OF WATER COMMISSIONERS

7-67

WATER WELL DRILLERS LOG

Herndon-Roman Well & Supply, Inc.

Date: 7-31, 1967, Driller: P. O. Box 42, County Lee
(When well drilled) SHANNON, MISSISSIPPI 39800 (Where well is located)

1) Owner of Land: HAL D. Kelso
(Name)
Rt 1 Dorsey, Miss
(Address)

2) Location: SW 1/4, NE 1/4, Sec. 15 T9R7E
3 miles NE of Mooroville
(distance) (direction) (Nearest Town)

3) Topography: Hills
(Hilly) (Flat) (Level)

4) Purpose of Well: Home
(Domestic Irrigation, Municipal, Industrial, Other)

Description & Color of Materials Sand, Clay, Red Clay, Shell, etc.	Thick- ness Feet	Depth Feet
surface sand & clay	0	35
blue clay	35-180	
sand	180-300	
stone	300	

Information upon completion of well:

1) Diameter 5 inches.

2) Total Depth 300 feet.

3) Water Level 95 feet below top of ground.

4) Cased to 39' dia. Size 5"

5) Screen: Size none, Length _____

6) Were any formations sealed against pollution?
 yes, no.

YES depth of formation 35'


by surface & sand

Drillers Remarks:

Yield in gpm: 5

Size pump: 1/2 HP sub

Type power: electric

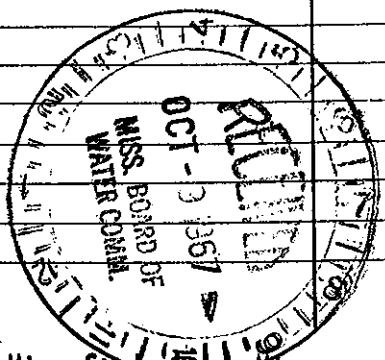

File this copy to Board of Water Commissioners 429 Miss. St. Jackson, Miss.