

LEE MISSISSIPPI BOARD OF WATER COMMISSIONERS

J 30  
11-21-61


CODED WATER WELL DRILLERS LOG

311  
H308

Date: 11-21, 1961, Driller: O. C. Webb County Lee  
(Name)

	Description & Color of Materials Sand, Clay, Red Clay, Shell, etc.	Thick- ness Feet	Depth Feet
(1) Owner of Land: <u>Boby Davis</u> (Name) <u>Lupelo miss</u> (Address)	soil to 30ft		
(2) Location: <u>1/4, 1/4, Sec. 22 T9R7</u> <u>3</u> miles <u>North</u> of <u>Mossville</u> (distance) (direction) (Nearest Town)	sand to 38ft blue mail to 160ft water sand to 300ft		
(3) Topography: <input checked="" type="checkbox"/> (Hilly) <input type="checkbox"/> (Flat) <input type="checkbox"/> (Level)			
(4) Purpose of Well: <input checked="" type="checkbox"/> (Domestic Irrigation) <input type="checkbox"/> (Municipal, Industrial, Other)			
Information upon completion of well:			
(1) Diameter <u>6</u> inches.			
(2) Total Depth <u>300</u> feet.			
(3) Water Level <u>127</u> feet below top of ground.			
(4) Cased to <u>42ft</u> , Size <u>6</u>			
(5) Screen: Size <u>6</u> , Length <u>6</u>			
(6) Were any formations sealed against pollution? <u>no</u>			
If YES depth of formation _____			
Why _____			
Drillers Remarks: <u>Has chicken houses</u>			
<u>163</u>			Well No.

CODED

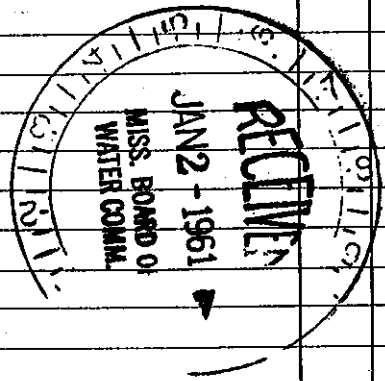

(Use Back Side)

Mail this copy to Board of Water Commissioners 429 Miss. St. Jackson, Miss.