

LEE  
J 3000

WATER WELL DRILLERS

Date: 4-24-62, 4/24, 1962, Driller: Fowler, County: LEE

(1) Owner of Land	Description & Color of Materials Sand, Clay, Red Clay, Shell, etc.	Thick- ness Feet	Depth Feet
(Name) <i>James O. Williams</i>			
(Address) <i>Rt. Dorey</i>			
(2) Location: $\frac{1}{4}$ , $\frac{1}{4}$ , Sec. <i>2245 R1E</i> <i>3</i> miles <i>NE</i> , of <i>Mooreville</i> (distance) (direction) (Nearest Town)			
(3) Topography: <i>Hilly</i> (Hilly) (Flat) (Level)			
(4) Purpose of Well: <i>Domestic</i> (Domestic Irrigation Municipal, Industrial, Other)			

Information upon completion of well:


- (1) Diameter 4" inches.
- (2) Total Depth 244' feet.
- (3) Water Level 90' feet below top of ground.
- (4) Cased to 24', Size \_\_\_\_\_
- (5) Screen: Size \_\_\_\_\_, Length \_\_\_\_\_
- (6) Were any formations sealed against pollution?  
✓ yes, \_\_\_\_\_ no.

If YES depth of formation \_\_\_\_\_

Why \_\_\_\_\_

Drillers Remarks: \_\_\_\_\_

CODED

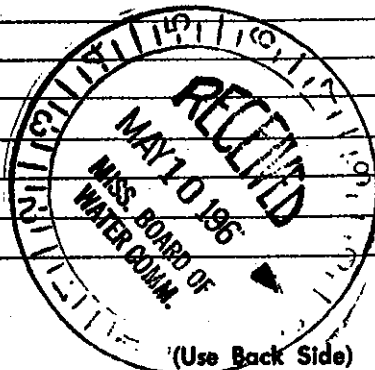

Well No.

166

Mail this copy to Board of Water Commissioners 429 Miss. St. Jackson, Miss.