

LEE MISSISSIPPI BOARD OF WATER COMMISSIONERS

JOB 40
6-8-62

CODED WATER WELL DRILLERS LOG

Date: 6/8, 1962, Driller: James Foster County: Lee
(Name)

(1) Owner of Land: <u>John H. Whelle</u> (Name)	Description & Color of Materials Sand, Clay, Red Clay, Shell, etc.	Thick- ness Feet	Depth Feet
<u>RT. 2 Tupelo</u> (Address)			
(2) Location: <u>1/4, 1/4, Sec. 30 T. 9^S R. 7^E</u>			
<u>7</u> miles <u>E</u> , of <u>Tupelo</u> (distance) (direction) (Nearest Town)			
(3) Topography: <u>Hilly</u> (Hilly) (Flat) (Level)			
(4) Purpose of Well: <u>Domestic</u> (Domestic Irrigation Municipal, Industrial, Other)			

CODED

Information upon completion of well:

(1) Diameter 4" inches.

(2) Total Depth 315' feet.

(3) Water Level 107' feet below top of ground.

(4) Cased to 43', Size 4"


(5) Screen: Size _____, Length _____

(6) Were any formations sealed against pollution?
_____ yes, _____ no.

If YES, depth of formation _____

Why _____

Drillers Remarks: _____

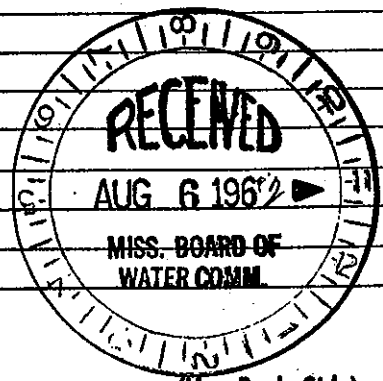

(Use Back Side)

Well No.

168