

County: Lee
 Permit #: _____
 Driller: Donald Smith Co., Inc.
 Date drilling completed: 1/15/10

State Well Report

Part 1 - Driller's Log

Mississippi Department of Environmental Quality
 Office of Land and Water Resources
 P.O. Box 10631
 Jackson, MS 39289-0631
 (601)961-5210
 (601)354-6938 (fax)

For Office Use Only:
 Aquifer: _____
 Well #: J57
 L. S. Elevation: _____
 E-log #: _____

State Law requires that this report be prepared by the license holder responsible for the work and filed with the Department at the above address within 30 days of completion of drilling of the well or borehole.

Information on Well Owner <i>(Landowner if borehole is not for a water well)</i>	Well or Borehole Location
Owner Name: <u>Mooreville-Richmond WA</u>	Latitude: <u>34° 19' 24" N</u> Longitude: <u>88° 34' 37" W</u>
Mailing Address: <u>PO Box 28</u>	Method of Lat/Long (circle one): Conventional Survey, <u>Hand-held GPS</u> , Survey-grade GPS
<u>Mooreville, MS 38857</u> City State Zip Code	USGS quad, <u>SW 1/4 SW 1/4 Sec 4 Twn 9S Rng 7E</u>
Telephone No. <u>(662) 844-0311</u>	Distance _____ Direction _____ Nearest Town _____ Miles _____ of _____ <u>"Oliver Site"</u>

Well / Borehole Data

Date drilling started: 10/21/09 Date drilling completed: 1/15/10 Hole depth: _____ Hole diameter: 17 1/2

Location of the source of any surface water used for drilling: public supply
 Method of dosing and volume of Chlorine used in drilling and development: potable water used

Logs run (circle all applicable): No log run Electric Gamma Ray Density Sonic Neutron Other: _____
 Name of organization running log(s): MS Geology Survey

Purpose of borehole (check one): Water Well Geotechnical/Geological Investigation _____ Ground Source Heat Pump _____
 Seismic Survey _____ Other (describe) _____

If drilling is not related to water well construction, skip the remainder of this block

Purpose of Well (check one): Home _____ Industrial _____ Public Supply Irrigation _____ Fish Culture _____ Other: _____

If a flowing well, method of flow regulation: Valve _____ Other (describe) _____

Static Water Level: 190 feet above or below (circle one) land surface Date measured: 1/05/10

Method of Measurement (circle one) steel tape electric tape air line other: _____

Well depth: 398' Well grouted to a depth of _____ feet Type of grout (circle one): Neat Cement Bentonite Mix

Casing length: 350 feet Casing diameter: 12 inches Type of casing: Steel

Screen length: 45 feet Screen diameter: 8 inches Type of screen: SS

Screen slot size: .25 inches Setting depth: From 353 feet to 398 feet

Type of completion (circle all applicable): Gravel packed Underreamed Telescoped Open hole Natural Development
 Other (describe): _____

Top of lap pipe or reduction in casing: 290 feet. *If telescoped or more than one screen, describe on next page*

The sketch below only required for water wells

If well telescopes, show depths on sketch.

Ground Level →

Description of formations encountered must be provided for all wells and boreholes, unless specifically exempted by regulations

Description of Formations Encountered	From (depth)	To (depth)
	Ground Level	
Red + Gray Clay	0	32
Gray Clay	32	288
Gray Clay + Sand	288	350
Sand	350	405
Choppy Clay	405	458

If more than one screen, show location of each on sketch


Sketch the property layout and include the following: 1) the well location; 2) any permanent structures on the property that may aid in locating the well; 3) any roads, power lines, or other items that may aid in locating the property and the well; 4) a north arrow.

Landowner Name: _____

I certify that the well/borehole was drilled, constructed, and completed in accordance with all applicable requirements of the Mississippi Department of Environmental Quality and the Mississippi Department of Health regulations, if applicable, and state laws.

Ronald E Smith 0-767 1/19/10
 Print Name of Responsible Licensee and License No. Date

Ronald E Smith AI
 Signature of Licensee

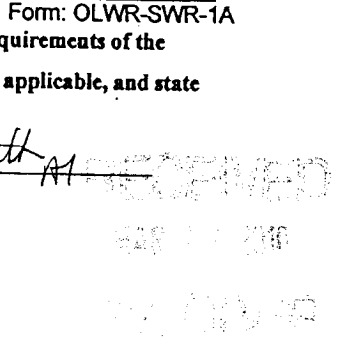

STATE WELL REPORT

Part 2

Pump Installer's Completion Report
 Mississippi Department of Environmental Quality
 Office of Land and Water Resources
 P.O. Box 10631
 Jackson, MS 39289-0631
 (601)961-5210
 (601)354-6938 (fax)

County: Lee
 Permit #: _____
 Driller: Donald Smith Co
 Date completed: 3/11/10
Copy information from block on Part 1

For Office Use Only:

Aquifer: _____
 Well #: J57
 Elevation: _____

This part of the report must be completed by a licensed water well contractor or a licensed pump installer. A copy of Part 1 of the report must be attached and both parts filed with the Department at the above address within 30 days of well completion.

Well Owner Information	Well Location
Owner Name: <u>Mooreville-Richmond WA</u>	Latitude: <u>341924N</u> Longitude: <u>883437W</u>
Mailing Address: <u>PO Box 28</u>	Method of Lat/Long (check one): Conventional Survey _____
<u>Mooreville, MS 38857</u>	USGS quad _____, Hand-held GPS <input checked="" type="checkbox"/> , Survey-grade GPS _____
City State Zip Code	<u>SW 1/4 SW 1/4 Sec 4 T 9S R 7E</u>
Telephone No. () _____	Distance Direction Nearest Town
	_____ Miles of _____ "Oliver Site"

Pump Type Circle one	Power Type Circle one
Air Lift Jet Submersible	Diesel Engine Gasoline Engine Natural Gas
Bucket Piston <input checked="" type="radio"/> Turbine	<input checked="" type="radio"/> Electric Motor Hand Tractor PTO
Centrifugal Rotary Flowing Well	Windmill Other (specify): _____
Other (specify): _____	Horse Power Rating of Motor: <u>40</u>
Date Pump Installed: <u>2/15/10</u>	Setting Depth: <u>322</u> feet
Rated Pump Capacity: <u>250</u> Gallons Per Minute	Number of Stages: <u>16</u>

Pump Test Data	Method of Measuring Water Level Circle one
Date Well Tested: <u>3/04/10</u>	Air Line <input checked="" type="radio"/> Electric Measuring Line Steel Tape
Static Water Level (A): <u>190</u> Feet Below Land Surface	Other (specify): _____
Pumping Water Level (B): <u>99</u> Feet Below Land Surface	For flowing well, measured shut in head: _____ feet
Drawdown [(B) - (A)]: <u>91</u> Feet Below Land Surface	Well yielded <u>257</u> GPM with a drawdown of
Test Pumping Rate: <u>257</u> Gallons Per Minute	<u>91</u> feet after <u>8</u> hours of pumping
Duration of Pump Test (minimum 4 hours): <u>8</u> hours	

I HEREBY CERTIFY that the above statements are true to the best of my knowledge.

Donald E Smith 0-767 Donald E Smith
 Print Name of Pump Installer and License No. (if applicable) Signature of Pump Installer

Form: OLWR-SWR-1B

RECEIVED

MAR 22 2010

BY: OLWR