

LEE

MISSISSIPPI BOARD OF WATER COMMISSIONERS

K 32

11-30-60

WATER WELL DRILLERS LOG

Herndon Well & Supply Co,

Date: 11/30, 1960, Driller: SHANNON, MISS. County Lee



(Name)

(1) Owner of Land: <u>Fair Powell</u> (Name)	Description & Color of Materials Sand, Clay, Red Clay, Shell, etc.	Thick- ness Feet	Depth Feet
<u>Rt 3 Tupelo Miss</u> (Address)	<u>sand &amp; clay</u> <u>blue shale</u>		<u>15</u>
(2) Location: <u>NW 1/4, NE 1/4, Sec 34 T10S R5E</u> <u>5 miles West of Verona</u> (distance) (direction) (Nearest Town)	<u>Sand</u> <u>to</u> <u>Bottom</u>		<u>400</u> <u>515</u>
(3) Topography: <u>Hills</u> (Hilly) (Flat) (Level)	<u>white frame</u>		
(4) Purpose of Well: <u>Home use</u> (Domestic Irrigation Municipal, Industrial, Other)	<u>in pine trees</u>		

Information upon completion of well:

- (1) Diameter 4 inches.
- (2) Total Depth 515 feet.
- (3) Water Level \_\_\_\_\_ feet below top of ground.
- (4) Cased to 21' 11", Size 4"
- (5) Screen: Size \_\_\_\_\_, Length \_\_\_\_\_
- (6) Were any formations sealed against pollution?  
✓ yes, \_\_\_\_\_ no.

If YES depth of formation 15 ft  
 Why surface & sand  
 Drillers Remarks: \_\_\_\_\_

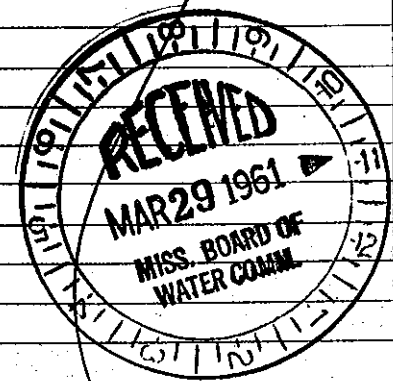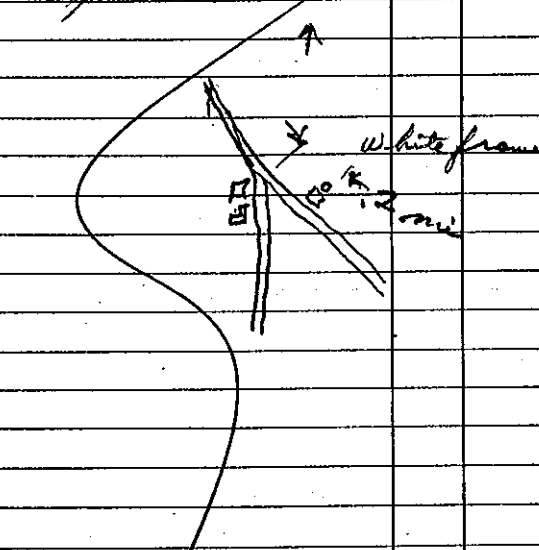

(Use Back Side)

Well No.

183