

MISSISSIPPI BOARD OF WATER COMMISSIONERS

LEE
K 33
7-1-61

WATER WELL DRILLERS LOG

HERNDON WELL & SUPPLY CO.


Date: July 1, 1961, Driller: P. O. BOX 42 County Lee
SHANNON, MISSISSIPPI

(1) Owner of Land	Description & Color of Materials Sand, Clay, Red Clay, Shell, etc.	Thick- ness Feet	Depth Feet
Joe Springfield (Name) Devonia, Miss. (Address)	surface sand & clay		0
(2) Location: 1/4, 1/4, Sec 36 T ²⁵ R ^{5E} 1 miles South, of Devonia (distance) (direction) (Nearest Town)	Blue rock	18	
(3) Topography: Flat (Hilly) (Flat) (Level)	Sand	280	
(4) Purpose of Well: Domestic (Domestic Irrigation Municipal, Industrial, Other)	Bottom	400	

Information upon completion of well:

- (1) Diameter 4 inches.
- (2) Total Depth 400 feet.
- (3) Water Level 20 feet below top of ground.
- (4) Cased to 21', Size 4"
- (5) Screen: Size _____, Length _____.
- (6) Were any formations sealed against pollution?
 yes, _____ no.

If YES depth of formation 18 ft.
Why Surface sand
Drillers Remarks: Dairy Bar and
trailer park

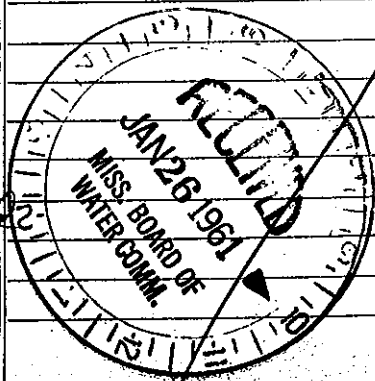

(Use Back Side)

Well No.