

MISSISSIPPI BOARD OF WATER COMMISSIONERS

LEE  
K 34  
7-3-61

WATER WELL DRILLERS LOG

HERNDON WELL & SUPPLY CO.

Date: July 3, 1961, Driller: HERNDON P. O. LOUISIANA County Lee  
SHANNON, MISSISSIPPI

	Description & Color of Materials Sand, Clay, Red Clay, Shell, etc.	Thick- ness Feet	Depth Feet
(1) Owner of Land: <u>Bill Fedwick</u> (Name) <u>J. Aug McCross</u> <u>Box 3 Tupelo</u> (Address)	<u>Surface sand</u>		<u>0</u>
(2) Location: <u>NE 1/4, NW 1/4, Sec 34 T 135 R 5E</u>	<u>&amp; clay</u>		
<u>4</u> miles <u>West</u> of <u>Herndon</u> , (distance) (direction) (Nearest Town) <u>20' below top</u>	<u>Blue rock</u>	<u>20</u>	
(3) Topography: <u>hillside</u> (Hilly) (Flat) (Level)	<u>sand</u>		<u>380</u>
(4) Purpose of Well: <u>Domestic</u> (Domestic Irrigation Municipal, Industrial, Other)	<u>Bottom</u>	<u>500</u>	


Information upon completion of well:

- (1) Diameter 4 inches.
- (2) Total Depth 500 feet.
- (3) Water Level 160 feet below top of ground.
- (4) Cased to 23', Size 4"
- (5) Screen: Size         , Length         .
- (6) Were any formations sealed against pollution?  
✓ yes,          no.

If YES depth of formation 20 ft  
Why Swamp & sand

Drillers Remarks:

187 ELEV 335

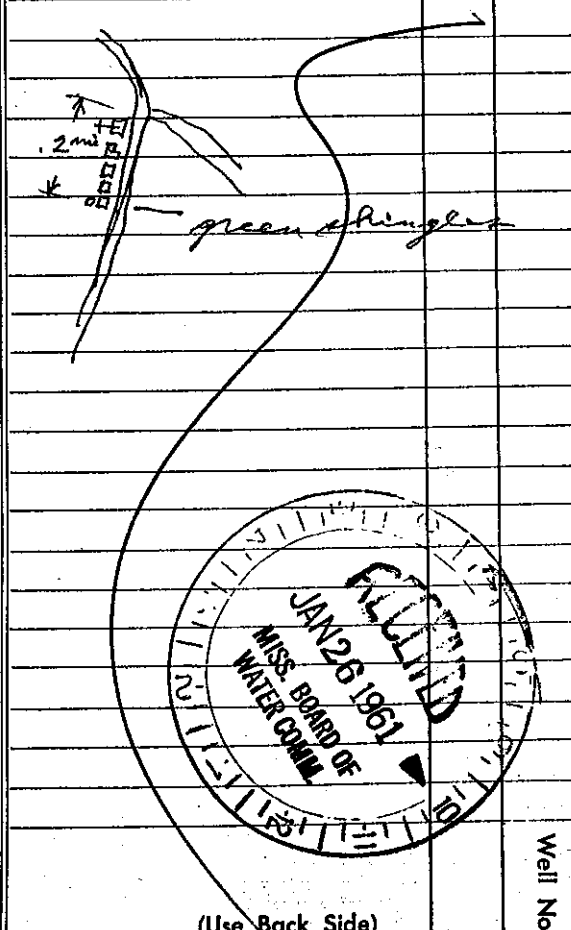

(Use Back Side)

Well No.

Mail this copy to Board of Water Commissioners 429 Miss. St. Jackson. Miss