

DRILLERS

LEE  
K 35  
9-19-60

**WATER WELL DRILLERS LOG**  
Herndon Well & Supply Co.  
SHANNON, MISS.

~~207~~

Date: Sept 18, 1960, Driller: \_\_\_\_\_ County Lee


(Name)

(1) Owner of Land:	Description & Color of Materials Sand, Clay, Red Clay, Shell, etc.	Thick- ness Feet	Depth Feet
<u>Joseph Whitesides</u> (Name) <u>Tupelo, Miss</u> (Address)	<u>Sand &amp; clay</u>		<u>294</u>
(2) Location: _____ 1/4, _____ 1/4, Sec. <u>12 T19 S</u>	<u>Blue Rock</u>		
<u>1</u> miles <u>West</u> of <u>Tupelo</u> (distance) (direction) (Nearest Town)	<u>Sand</u>		<u>315</u>
(3) Topography: <u>Flat</u> (Hilly) (Flat) (Level)	<u>Bottom</u>		<u>481</u>
(4) Purpose of Well: <u>Home use</u> (Domestic Irrigation Municipal, Industrial, Other)			

Information upon completion of well:

- (1) Diameter 4 inches.
- (2) Total Depth 481 feet.
- (3) Water Level 200 feet below top of ground.
- (4) Cased to 441', Size 4" and 2"
- (5) Screen: Size 2", Length 2 1/2'
- (6) Were any formations sealed against pollution?  
X yes, \_\_\_\_\_ no.

If YES depth of formation 294 ft  
Why Surface & sand  
Drillers Remarks: Sub.  
old over

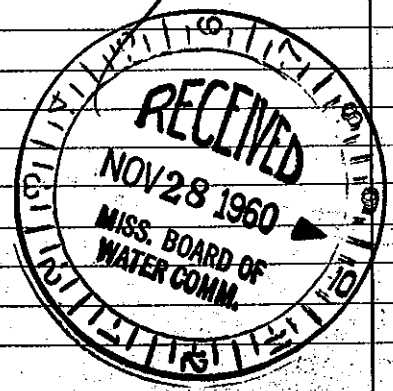

180 ELEV 340

(Use Back Side)

Well No.

Retain this copy for your office files.