

LEE

MISSISSIPPI BOARD OF WATER

K 36
9-3-60

WATER WELL DRILLERS LOG

~~K 36~~

Herndon Well & Supply Co.

Date: Sept 3, 1960, Driller: SHANNON, MISS. County: Lee

SALMON (Name)

(1) Owner of Land: Larry D. Salmon
(Name)
Rt 3 Tupelo, Miss
(Address)

(2) Location: 1/4, 1/4, Sec. 17 10 R 5
3 miles South of Bissell
(distance) (direction) (Nearest Town)

(3) Topography: High top 5 feet below
(Hilly) (Flat) (Level)

(4) Purpose of Well: Home use
(Domestic Irrigation
Municipal, Industrial, Other)

Description & Color of Materials Sand, Clay, Red Clay, Shell, etc.	Thick- ness Feet	Depth Feet
Sand & Clay		20
Blue loam		
Sand	475	
Bottom	580	

Information upon completion of well:

(1) Diameter 4 inches.


(2) Total Depth 580 feet.

(3) Water Level 150 feet below top of ground.

(4) Cased to 21 ft, Size 4 in.

(5) Screen: Size , Length .


(6) Were any formations sealed against pollution?
X yes, no.

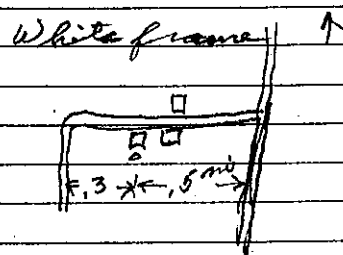

If YES depth of formation 20 ft

Why Surface & Sand

Drillers Remarks:

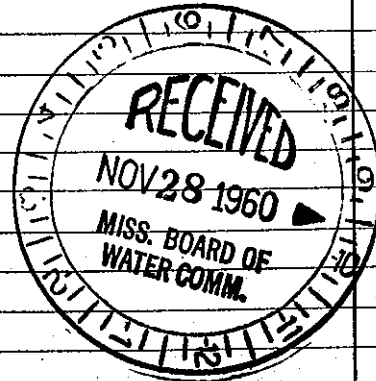

179 ELEV 360

(Use Back Side)

Well No.