

LEE

MISSISSIPPI BOARD OF WATER COMMISSIONERS

K37

~~K200~~

11-16-60

WATER WELL DRILLERS LOG

Herndon Well & Supply Co.

Date: 11/16, 1960, Driller: SHANNON, MISS. County Lee

(Name)

| | Description & Color of Materials Sand, Clay, Red Clay, Shell, etc. | Thick- ness Feet | Depth Feet |
|---|---|------------------------|---------------|
| (1) Owner of Land: <u>Lamar Metcalf</u> (Name) <u>RT 3 Tupelo, Miss</u> (Address) | <u>Sand & Clay</u> <u>Blue Rock</u> | | <u>18</u> |
| (2) Location: <u>1/4, 1/4, Sec 29 T 100 S</u> <u>5 miles West of Jena</u> (distance) (direction) (Nearest Town) | <u>Sand</u> <u>S</u> | | <u>440</u> |
| (3) Topography: <u>Flat Hilltop</u> (Hilly) (Flat) (Level) | <u>Bottom</u> | | <u>540</u> |
| (4) Purpose of Well: <u>Home Use</u> (Domestic Irrigation Municipal, Industrial, Other) | <u>AN</u> | | |



Information upon completion of well:

- (1) Diameter 4 inches.
- (2) Total Depth 540 feet.
- (3) Water Level 100 feet below top of ground.
- (4) Cased to 20' 4" Size 4"
- (5) Screen: Size , Length .
- (6) Were any formations sealed against pollution?
 yes, no.

If YES depth of formation 16 ft

Why Surface & Sand

Drillers Remarks: rod

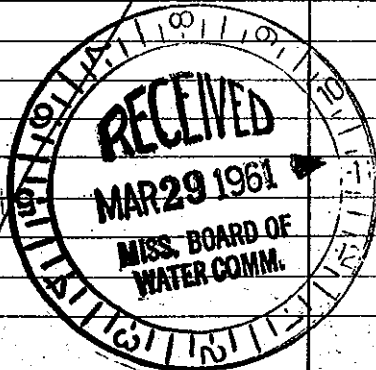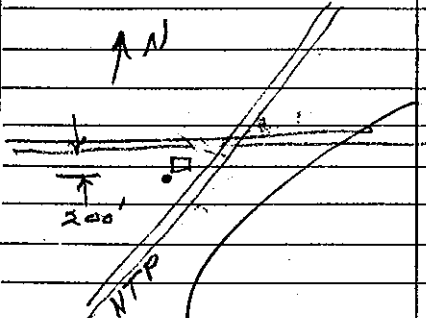

(Use Back Side)

Well No.

182 ELEV. 300