

LEE

MISSISSIPPI BOARD OF WATER COMMISSIONERS

K38

5-11-61

WATER WELL DRILLERS LOG

Date: May 11, 1961, Driller: O. C. Webb County Lee
(Name)

(1) Owner of Land:	Description & Color of Materials Sand, Clay, Red Clay, Shell, etc.	Thick- ness Feet	Depth Feet
<u>A. B. Caruth</u> (Name) <u>Tupelo Miss</u> (Address)	<u>Soil to 18ft</u> <u>Blue muck to</u> <u>150ft sand</u> <u>Rock 6 in water</u> <u>sand to 145ft</u> <u>Blue muck</u> <u>to 385ft sand</u> <u>Rock 5 in water</u> <u>sand to 530ft</u>		
(2) Location: <u>1/4, 1/4, Sec. 11 T10R6</u> <u>5 miles South West of Tupelo</u> (distance) (direction) (Nearest Town)			
(3) Topography: <u>Level</u> (Hilly) (Flat) (Level)			
(4) Purpose of Well: <u>Domestic Irrigation</u> (Domestic Irrigation Municipal, Industrial, Other)			

Information upon completion of well:


- (1) Diameter 4 inches.
- (2) Total Depth 530 feet.
- (3) Water Level 145 feet below top of ground.
- (4) Cased to 197ft, Size 4 in.
- (5) Screen: Size _____, Length _____.
- (6) Were any formations sealed against pollution?
_____ yes, _____ no.

If YES depth of formation _____

Why _____

Drillers Remarks: not located

184

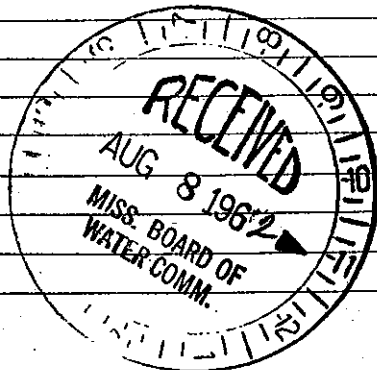

(Use Back Side)

Well No.