

LEE

MISSISSIPPI BOARD OF WATER COMMISSIONERS


K 39


WATER WELL DRILLERS LOG

5-16-61

Date: May 16, 1961, Driller: O.C. Webb County: Lee

(Name)

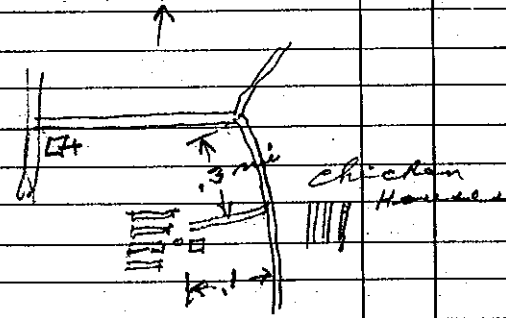	Description & Color of Materials Sand, Clay, Red Clay, Shell, etc.	Thick- ness Feet	Depth Feet
(1) Owner of Land: <u>Ray Parnell</u> (Name) <u>Tupelo Miss</u> (Address)	soil to 2 3 ft		
(2) Location: <u>SW 1/4, SW 1/4, Sec. 27 T10R5 S E</u> <u>4 miles West</u> , of <u>Verona</u> (distance) (direction) (Nearest Town)	Blue marl to 4 60 ft sand 6 in water sand to 60 ft		
(3) Topography: <input checked="" type="checkbox"/> (Hilly) <input type="checkbox"/> (Flat) <input type="checkbox"/> (Level)			
(4) Purpose of Well: <u>Chicken House</u> (Domestic Irrigation Municipal, Industrial, Other)			
Information upon completion of well:			
(1) Diameter <u>5</u> inches.			
(2) Total Depth <u>600</u> feet.			
(3) Water Level <u>130</u> ^{137 3/22/67} feet below top of ground.			
(4) Cased to <u>26 ft</u> , Size <u>5"</u>			
(5) Screen: Size _____, Length _____			
(6) Were any formations sealed against pollution? _____ yes, _____ no.			
If YES depth of formation _____			
Why _____			
Drillers Remarks: <u>1 M.P. Sand</u>			
<u>185 ELEV 330</u>			

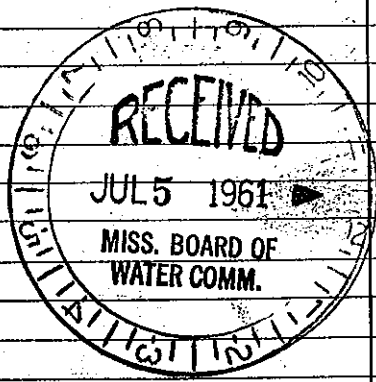

(Use Back Side)

Well No.

Mail this copy to Board of Water Commissioners 429 Miss. St. Jackson, Miss